
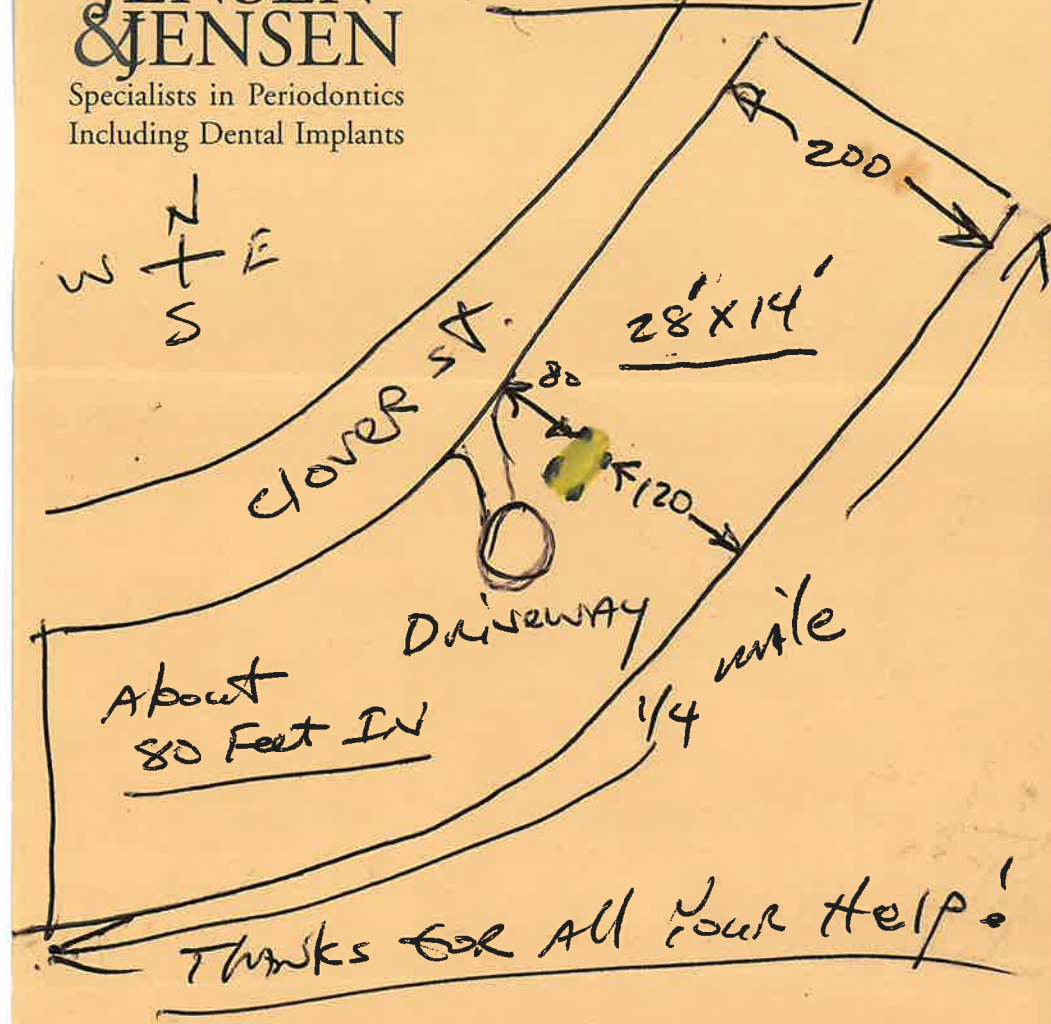


# JENSEN & JENSEN

Specialists in Periodontics  
Including Dental Implants

Hello Henry

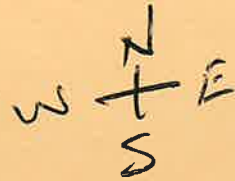

QUESTIONS?

PLEASE FEEL  
FREE TO CALL  
ME!

612-615-6783

Thanks Again  
Andy  
Meysembourg

Maplewood 651.770.3014  
Woodbury 651.738.9050  
Stillwater 651.439.8032  
Forest Lake 651.464.2290

[www.dentalimplants-mn.com](http://www.dentalimplants-mn.com)