




CONTINUATION OF THE SURVEY
 BEING IN BOOK 14 OF THE AGEN
 COUNTY RECORDS BY THE

Surveyor's Note
 The property address for the subject property is:
 The Parcel Number for the subject property is 20-1-314300
 The survey was completed without the benefit of a title commitment or title report, there may be
 comments or other limiting factors that affect the subject property that are not shown on this survey.

Local Description
 Lot 3, Block 58, SHESHEBE POINT THIRD ADDITION, Aitkin County, Minnesota.

Lake Minnewawa
 Special Development Classification

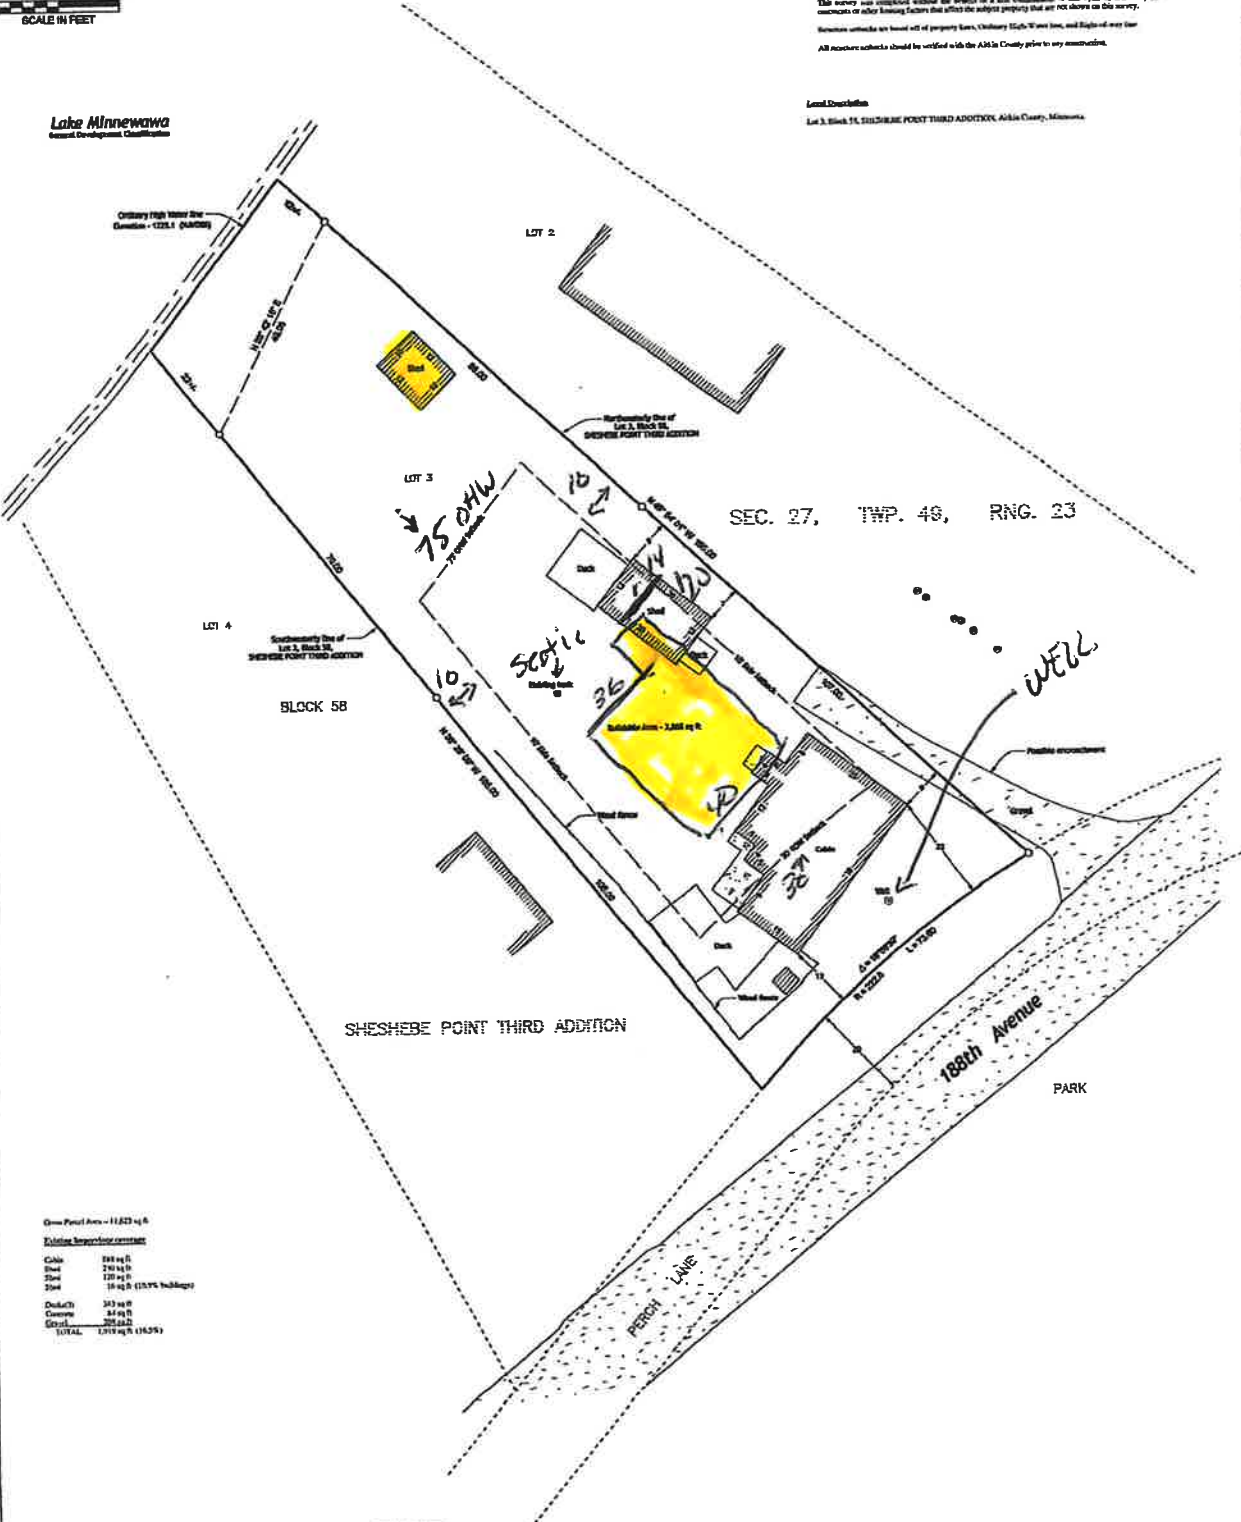


SHESHEBE POINT THIRD ADDITION

188th Avenue
 PARK




- PROPERTY BOUNDARY LEGEND**
- SET BACK FENCE WITH CAP OR OTHER VISIBLE MARK
 - FENCED PROPERTY
 - ✕ CORNER POSITION

- MAPPING LEGEND**
- WELL
 - BENCH CLEARANCE

NO.	REVISIONS SINCE PREVIOUS EDITION	DATE

KLP
 KENNETH LEAS ORLEO
 SURVEYOR - REGISTERED - PLANNING

I HEREBY CERTIFY THAT THIS PLAN, SURVEY OR REPORT WAS PREPARED BY ME OR UNDER MY DIRECT SUPERVISION AND THAT I AM A LICENSED REGISTERED LAND SURVEYOR UNDER THE LAWS OF THE STATE OF MINNESOTA.

Signature: *[Signature]* 7/18/2023

PROJECT NO. JUHKC2301

CERTIFICATE OF SURVEY
 Topographic and Property Boundary Survey

Casey Juster
 Section 27, Township 49 North, Range 23 West
 Aitkin County, Minnesota

Sheet No. 1 of 1