







PROPOSED PROPERTY LINE ADJUSTMENTS

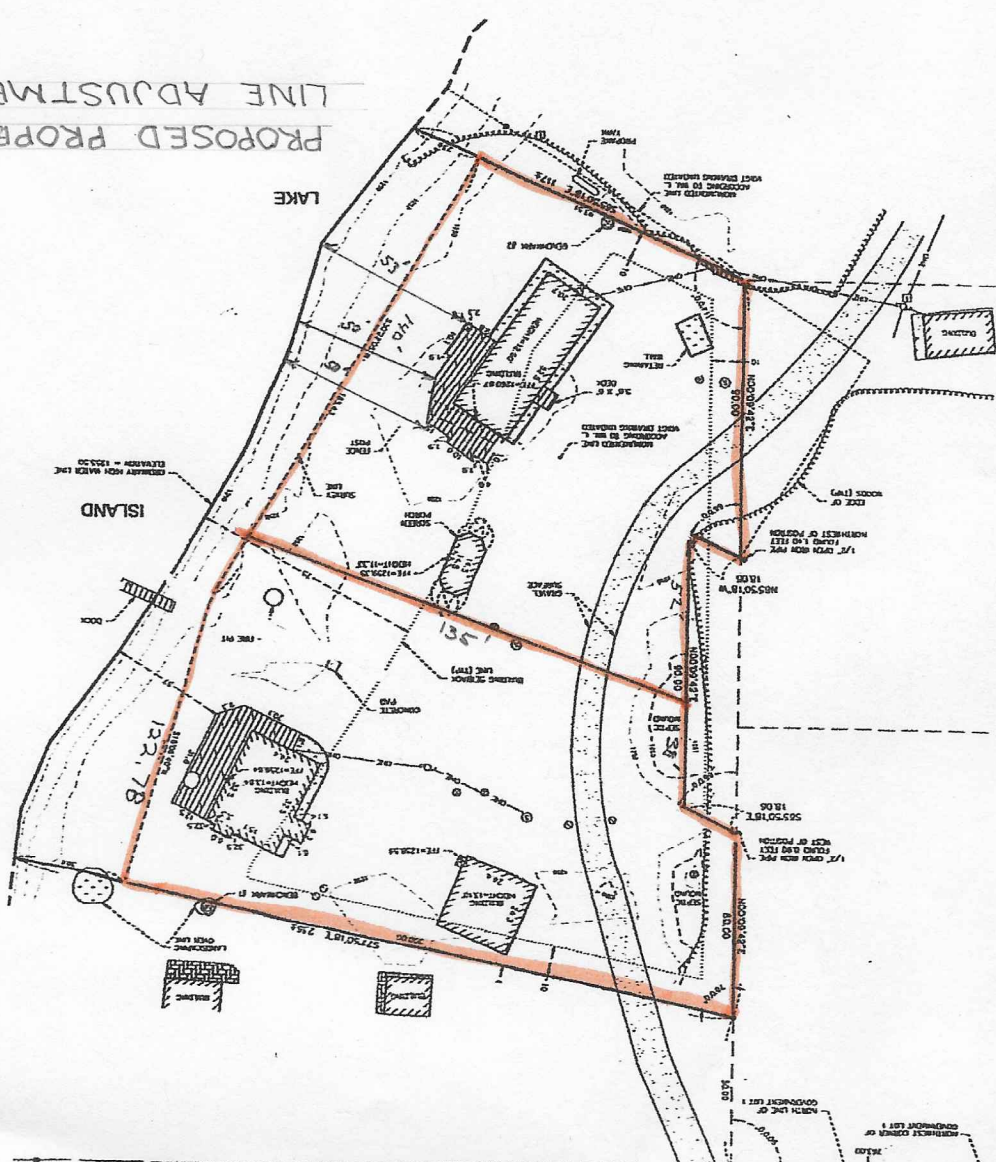

**CERTIFICATE OF SURVEY**  
 PART OF GOVERNMENT LOT 1,  
 SECTION 6, TOWNSHIP 45, RANGE 27,  
 ATKIN COUNTY, MINNESOTA

WIDSETH ARCHITECTS • ENGINEERS • SURVEYORS