

CERTIFICATE OF SURVEY

LEGAL DESCRIPTION:


Lot 3, PINHURST, Aitkin County, Minnesota.

Subject to reservations, restrictions or easements of record, if any.



THE BEARING SYSTEM IS ASSUMED

o — Denotes iron monument capped RLS 13591

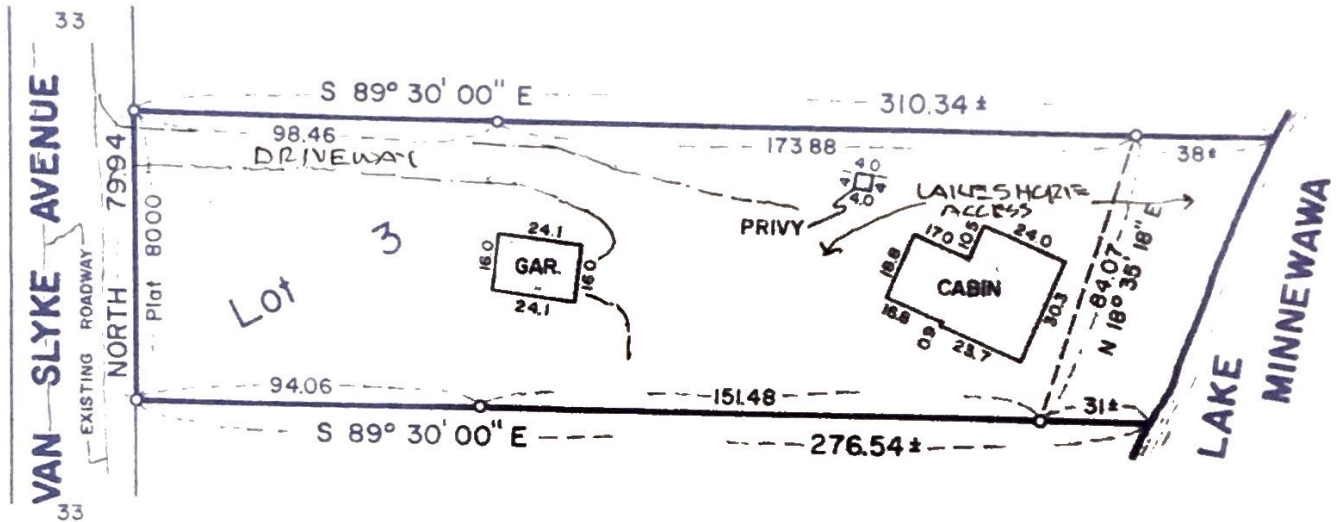

I hereby certify that this report, plan, or survey was prepared by me or under my direct supervision and that I am a duly Registered Land Surveyor under the laws of the State of Minnesota.

Tommy Joe Fulton

Date May 30th, 1985 Registration No. 13591

TOMMY JOE FULTON
LAND SURVEYOR
 Rte. 4, Box 64
 Aitkin, Minnesota 56431
 Phone: (218) 927 - 6616

SCALE
 1" = 50'

BOOK	PAGE
4	75

FILE NO.
 212

For:
JACK J. & CHRISTINA L.
KARNOWSKI