


117th St

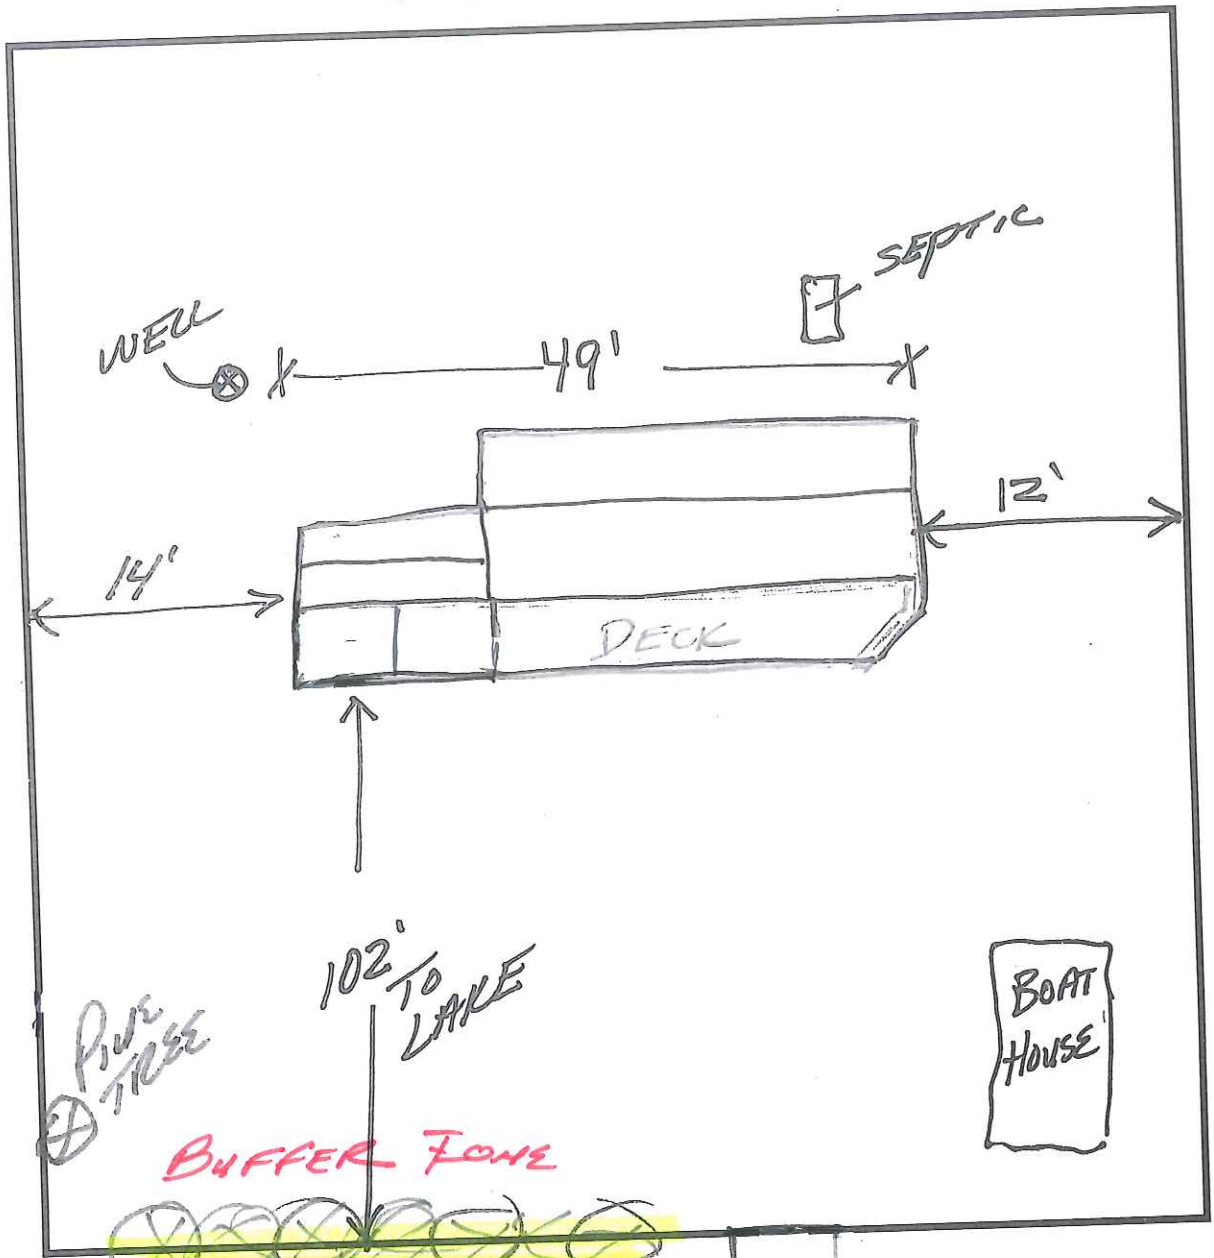

No

ADD
BOULDERS →

South PINE
LAKE

DOCK