


Rian Pole Building Location  
37500 Dove Street, Aitkin MN  
Parcel 31-0-066500

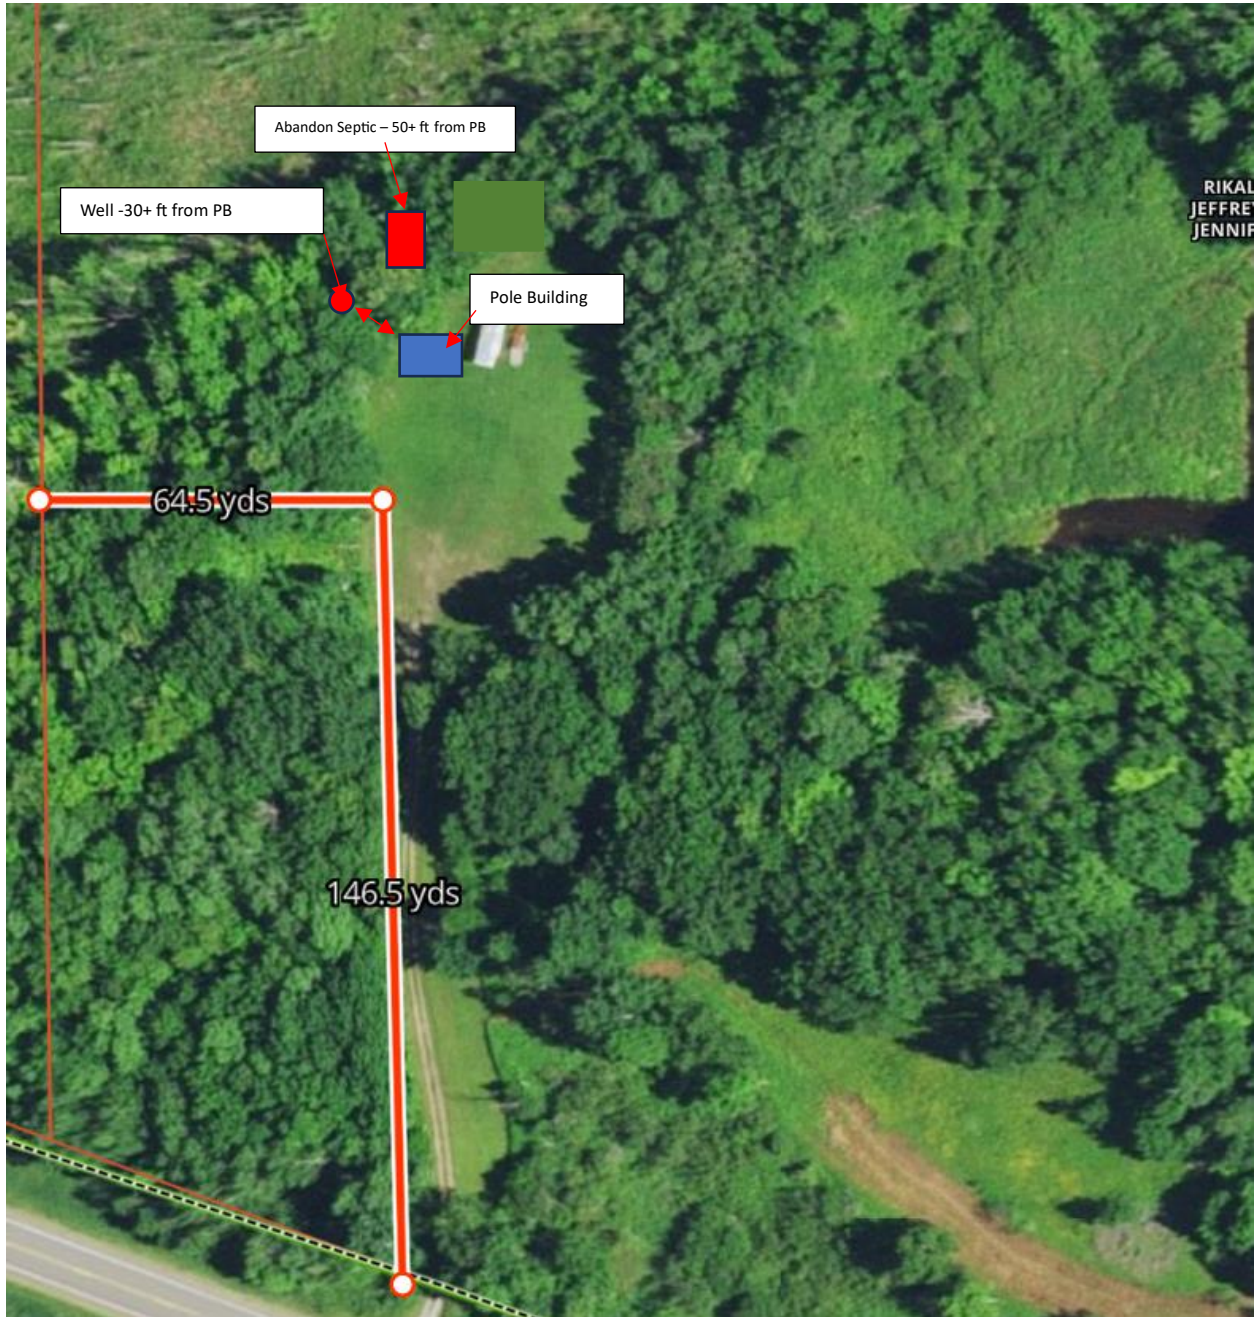

Rian Pole Building Location  
37500 Dove Street, Aitkin MN  
Parcel 31-0-066500

