

LEGEND

- CONSTRUCTION LIMITS
- 7" CONCRETE PAVEMENT. SEE INSET A, 1/C502
- 6" CONCRETE PAVEMENT. SEE INSET B, 1/C502
- 4" CONCRETE WALK. SEE INSET C, 1/C502
- CONCRETE JOINTS. SEE 2/C502
- BITUMINOUS PAVEMENT. SEE INSET D, 1/C502
- GRAVEL SHOULDER
- 4" TOPSOIL & SOD
- 4" TOPSOIL & SEED

SHEET NOTES

1. PREVENT FROM DAMAGE ALL SURFACES OUTSIDE THE CONSTRUCTION LIMITS. RESTORE ALL DISTURBED AREAS DUE TO CONSTRUCTION ACTIVITIES TO PRE-CONSTRUCTION CONDITION UNLESS OTHERWISE NOTED IN THE DRAWINGS.
2. PROVIDE BITUMINOUS TACK COAT BETWEEN PROPOSED BITUMINOUS PAVEMENTS AND ALL ADJACENT CONCRETE OR BITUMINOUS SURFACES.
3. PROVIDE BITUMINOUS TACK COAT BETWEEN THE WEARING AND NON-WEARING COURSES FOR ALL PROPOSED BITUMINOUS PAVEMENTS.
4. SAW CUT ALL EXISTING PAVEMENTS ADJACENT TO PROPOSED PAVEMENTS ALONG A NEAT LINE AND FULL SAW DEPTH. SAW CUT ALL EXISTING CONCRETE PAVEMENTS OR CURB AT THE NEAREST EXISTING JOINT.
5. UNLESS OTHERWISE NOTED, ALL DIMENSIONS ARE TO THE BACK OF CURB.
6. PROVIDE 1/2" EXPANSION JOINT, IN ACCORDANCE WITH DETAIL 2 ON SHEET C502, AT ALL INTERFACES BETWEEN STRUCTURES AND ALL CONCRETE PAVEMENT OR WALKS UNLESS NOTED OTHERWISE.
7. ONLY PLACE FILL MATERIALS ON COMPETENT, INSPECTED SUBGRADE.

SIGN KEY NOTES		
SIGN TYPE	SIZE	NOTES
1 ACCESSIBLE PARKING SIGN	12"x18"	COMPLY WITH MN ACCESSIBILITY CODE SECTION 502, 1-SIDED, WHITE LETTERS ON BLUE BACKGROUND
2 STOP SIGN	30"x30"	WHITE LETTERS ON RED BACKGROUND

THIS SQUARE APPEARS 1/2" x 1/2" ON FULL SIZE SHEETS

2	02/09/2024	BID/PERMIT SET
1	01/22/2024	OWNER REVIEW SET
NO	DATE	ISSUED FOR

1	02/09/2024	AS1#1
NO	DATE	REVISION

I HEREBY CERTIFY that this plan, specification or report was prepared by me or under my direct supervision and that I am a duly Licensed Professional Engineer under the laws of the State of Minnesota.

SIGNATURE: *Jordan Cabak*

TYPED OR PRINTED NAME: JORDAN CABAK

DATE: 02/09/2024 REG. NO.: 52249


COPYRIGHT 2024 BY LHB, INC. ALL RIGHTS RESERVED.

PROJECT NAME:
**DOLLAR GENERAL
 STORE 30613**
 321ST AVE
 MALMO, MN 56431

DRAWING TITLE:
**SURFACING & LAYOUT
 PLAN**

DRAWN BY: DPG
 CHECKED BY: BJH
 PROJ. NO.: 236502
 DRAWING NO.:

C401

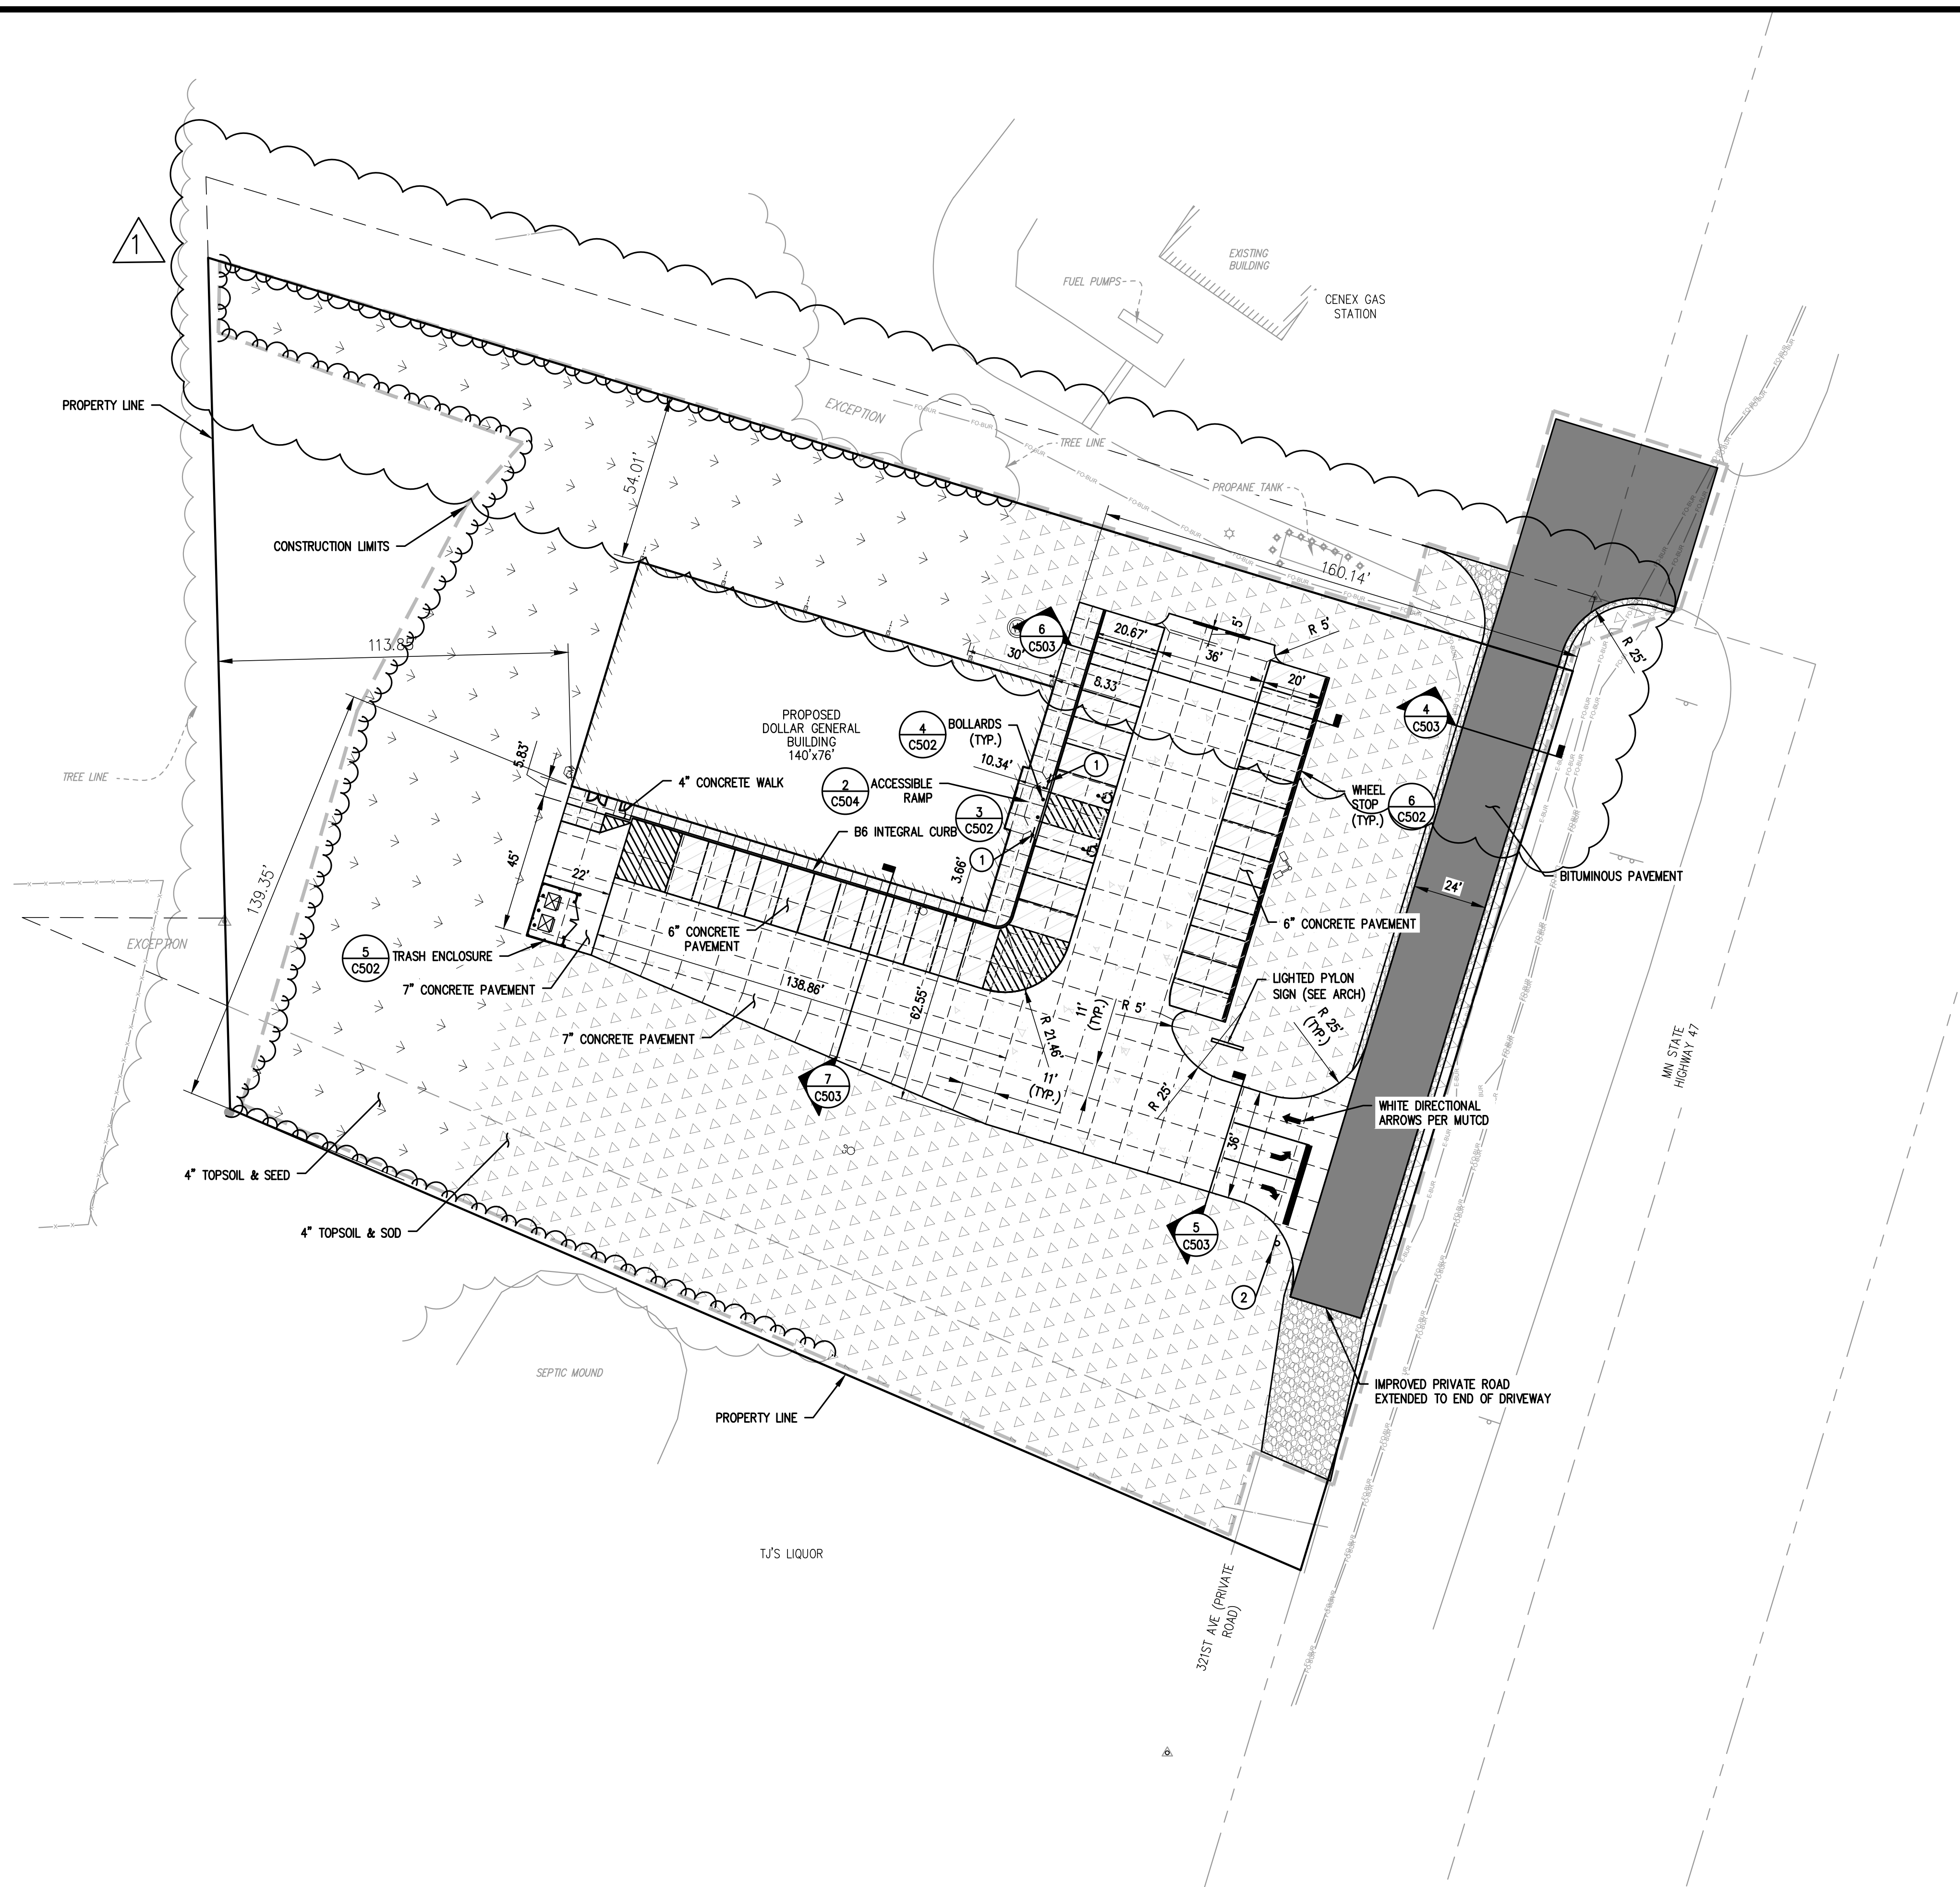

WARNING
 LOCATION OF ALL UNDERGROUND UTILITIES SHALL BE VERIFIED BY THE CONTRACTOR. CALL BEFORE DIGGING.
 MINNESOTA ONE-CALL SYSTEM
 1-800-252-1166
 REQUIRED BY MN STATUTE 216D

