



**MAIN LEVEL FLOOR PLAN**  
SCALE: 1/4"=1'-0"

28'  
Porch

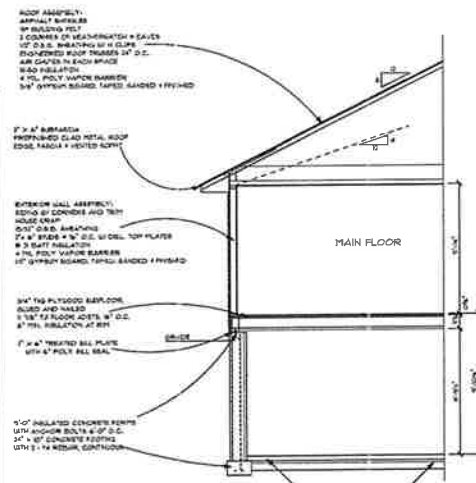

**WALL SECTION**  
SCALE: 1/4"=1'-0"

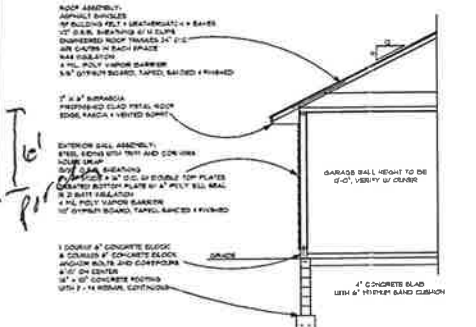

**GARAGE SECTION**  
SCALE: 1/4"=1'-0"

NOTE:  
ALL DIMENSIONS ARE TO FACE OF STUD UNLESS OTHERWISE NOTED.  
2" x 2" x 10' HEADERS OVER ALL EXTERIOR OPENINGS UNLESS OTHERWISE NOTED.  
DOUBLE TRUSSES ON OPENINGS WIDER THAN 8 FEET.  
EXTERIOR DOORS BY THERMA-TU OR EQUAL. SINGLES ARE HANVON INTEGRITY, WITH ALL FALL PROTECTION REQUIREMENTS. VERIFY ALL SIZES AND ROUGH OPENINGS WITH OWNER AND MANUFACTURER. ANY WINDOW WITHIN 10' OF THE FLOOR IS TO BE TERRAZZO. WINDOW LEADER HEIGHT TO BE 6'-0" 1/8" UNLESS NOTED. VERIFY EXTERIOR DOOR ROUGH OPENING HEIGHTS.

VERIFY ALL TRUSSES, BEAMS AND MICRO-LAP'S WITH TRUSS MANUFACTURER. INSULATE AROUND ALL BATHROOMS AND BEDROOMS.

MEETING OF ENERGY CODE REQUIREMENTS TO BE THE RESPONSIBILITY OF CONTRACTOR. THIS PLAN WAS DESIGNED TO COMPLY WITH 2015 MN STATE BUILDING CODE AT THE TIME, AND FOR THE LOCATION THEY WERE DRAINED. CHECK WITH YOUR CONTRACTOR REGARDING LOCAL CODES THAT MAY VARY. THE OWNER AND CONTRACTOR ASSUMES THE RESPONSIBILITY TO COMPLY WITH LOCAL CODES.

**P.F.S. DESIGN LLC**  
218-821-0630  
PROJECT FOR: JEFF KIM ROLSCHAU  
DATE: JANUARY 8, 2021  
REVISED JANUARY 27, 2021  
REVISED MARCH 8, 2021

PAGE NO. **3 of 3**