


HWY 47

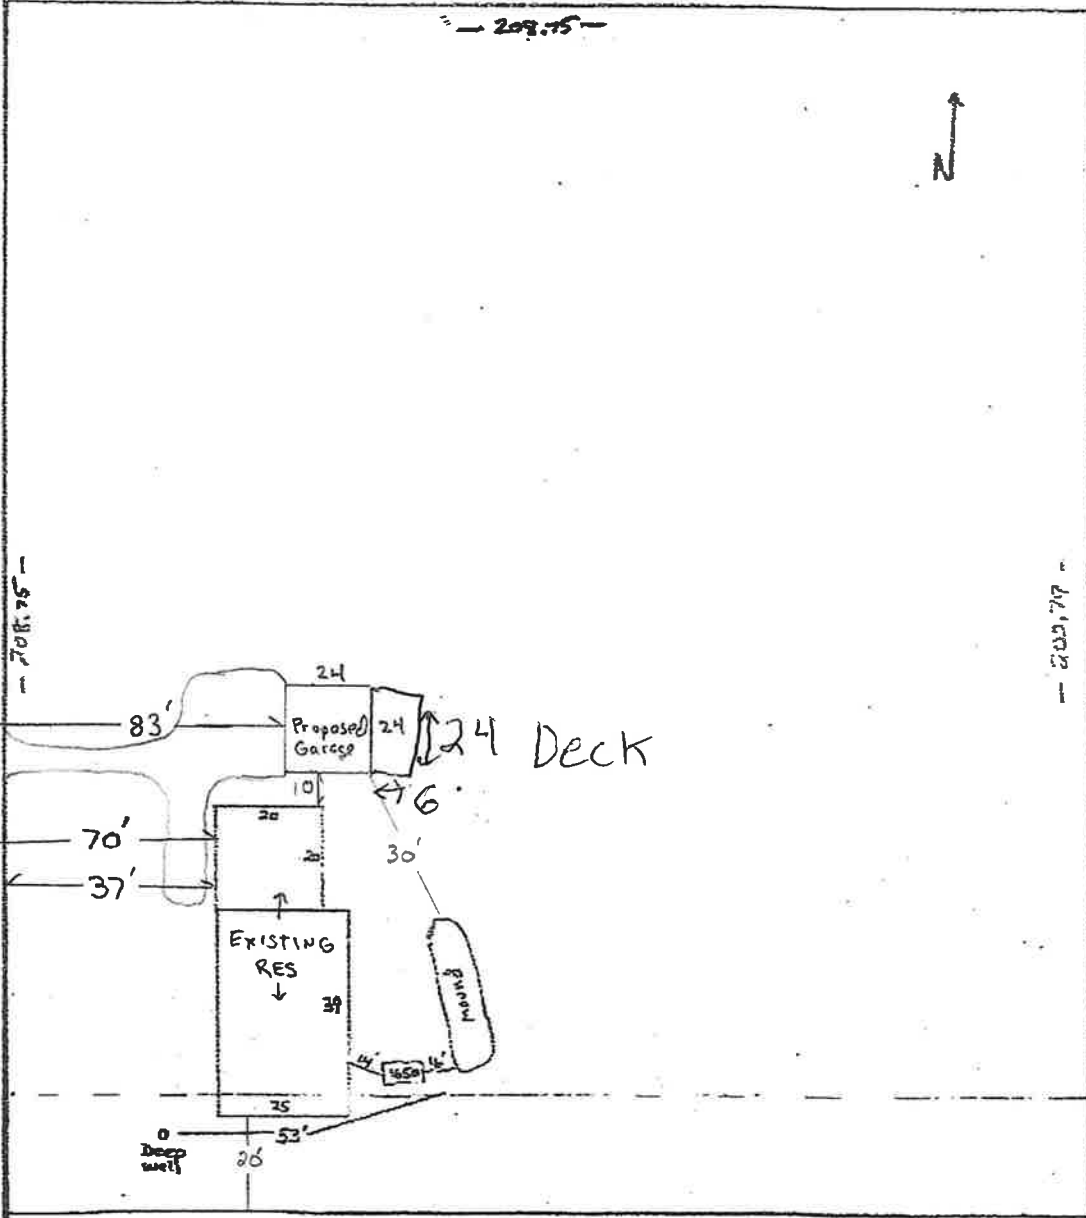

209.02