


McGregor Title

Plat Drawing
(This is not a Survey)

1
North

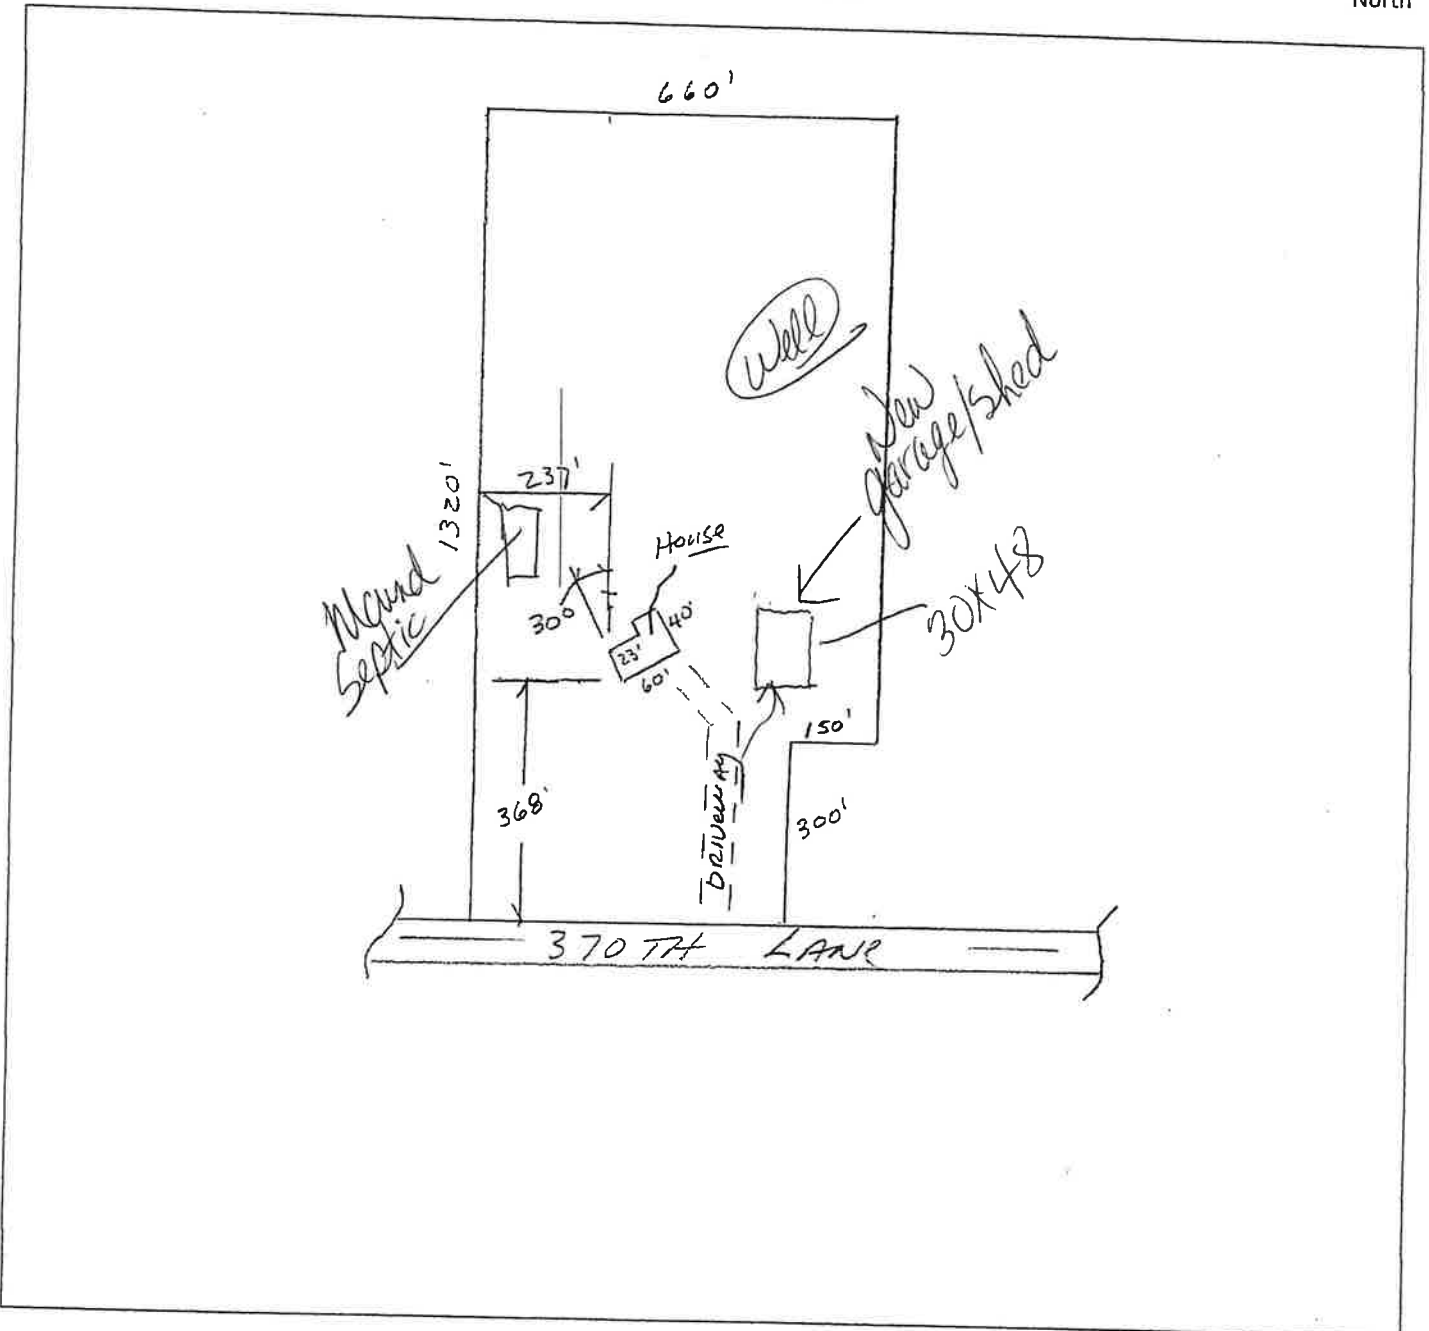

File # MT 2412546 Buyer / Owner: HERGOTT / KANGAS
Property Address: 20564 370TH LANE, MCGREGOR, MT
Legal Description: R10 EAST 1/2 of SE 1/4 of SW 1/4,
SEC 17 TWP. 47
RANGE 23
Date: 4/20/20 By Bill Schoenecker

The location of the improvements shown on this drawing are approximate and are based on a visual inspection of the premises. The lot dimensions and legal description values are taken from the recorded plat and/or county records. This drawing is for informational purposes only and should not be used as a survey. For exact corner locations, consult a Registered Surveyor. This information does not constitute a liability of the Northpine Company and/or Bill Schoenecker, and is intended for mortgage purposes only.