



limits

Bldg
Existing Cabin
 $21'6" \times 24'5" = 526.75$
 $14'6" \times 12'6" = 183.96$
 Deck $5 \times 12 = 60.00$
 Lift Deck $10 \times 4 = 40$
 Lake Deck $8.5 \times 12 = 102$
 Stairs $3 \times 7.5 = 22.5$
 Stairs $3 \times 10 = 30$

proposed addit. 328.5
 Total 1293.71

Lot Size 9452#
 $15\% = 1417.8$
 $25\% = 2363$

patio: $14 \times 18 = 252$
 Driveway = $30 \times 14 = 420$
 parking 672

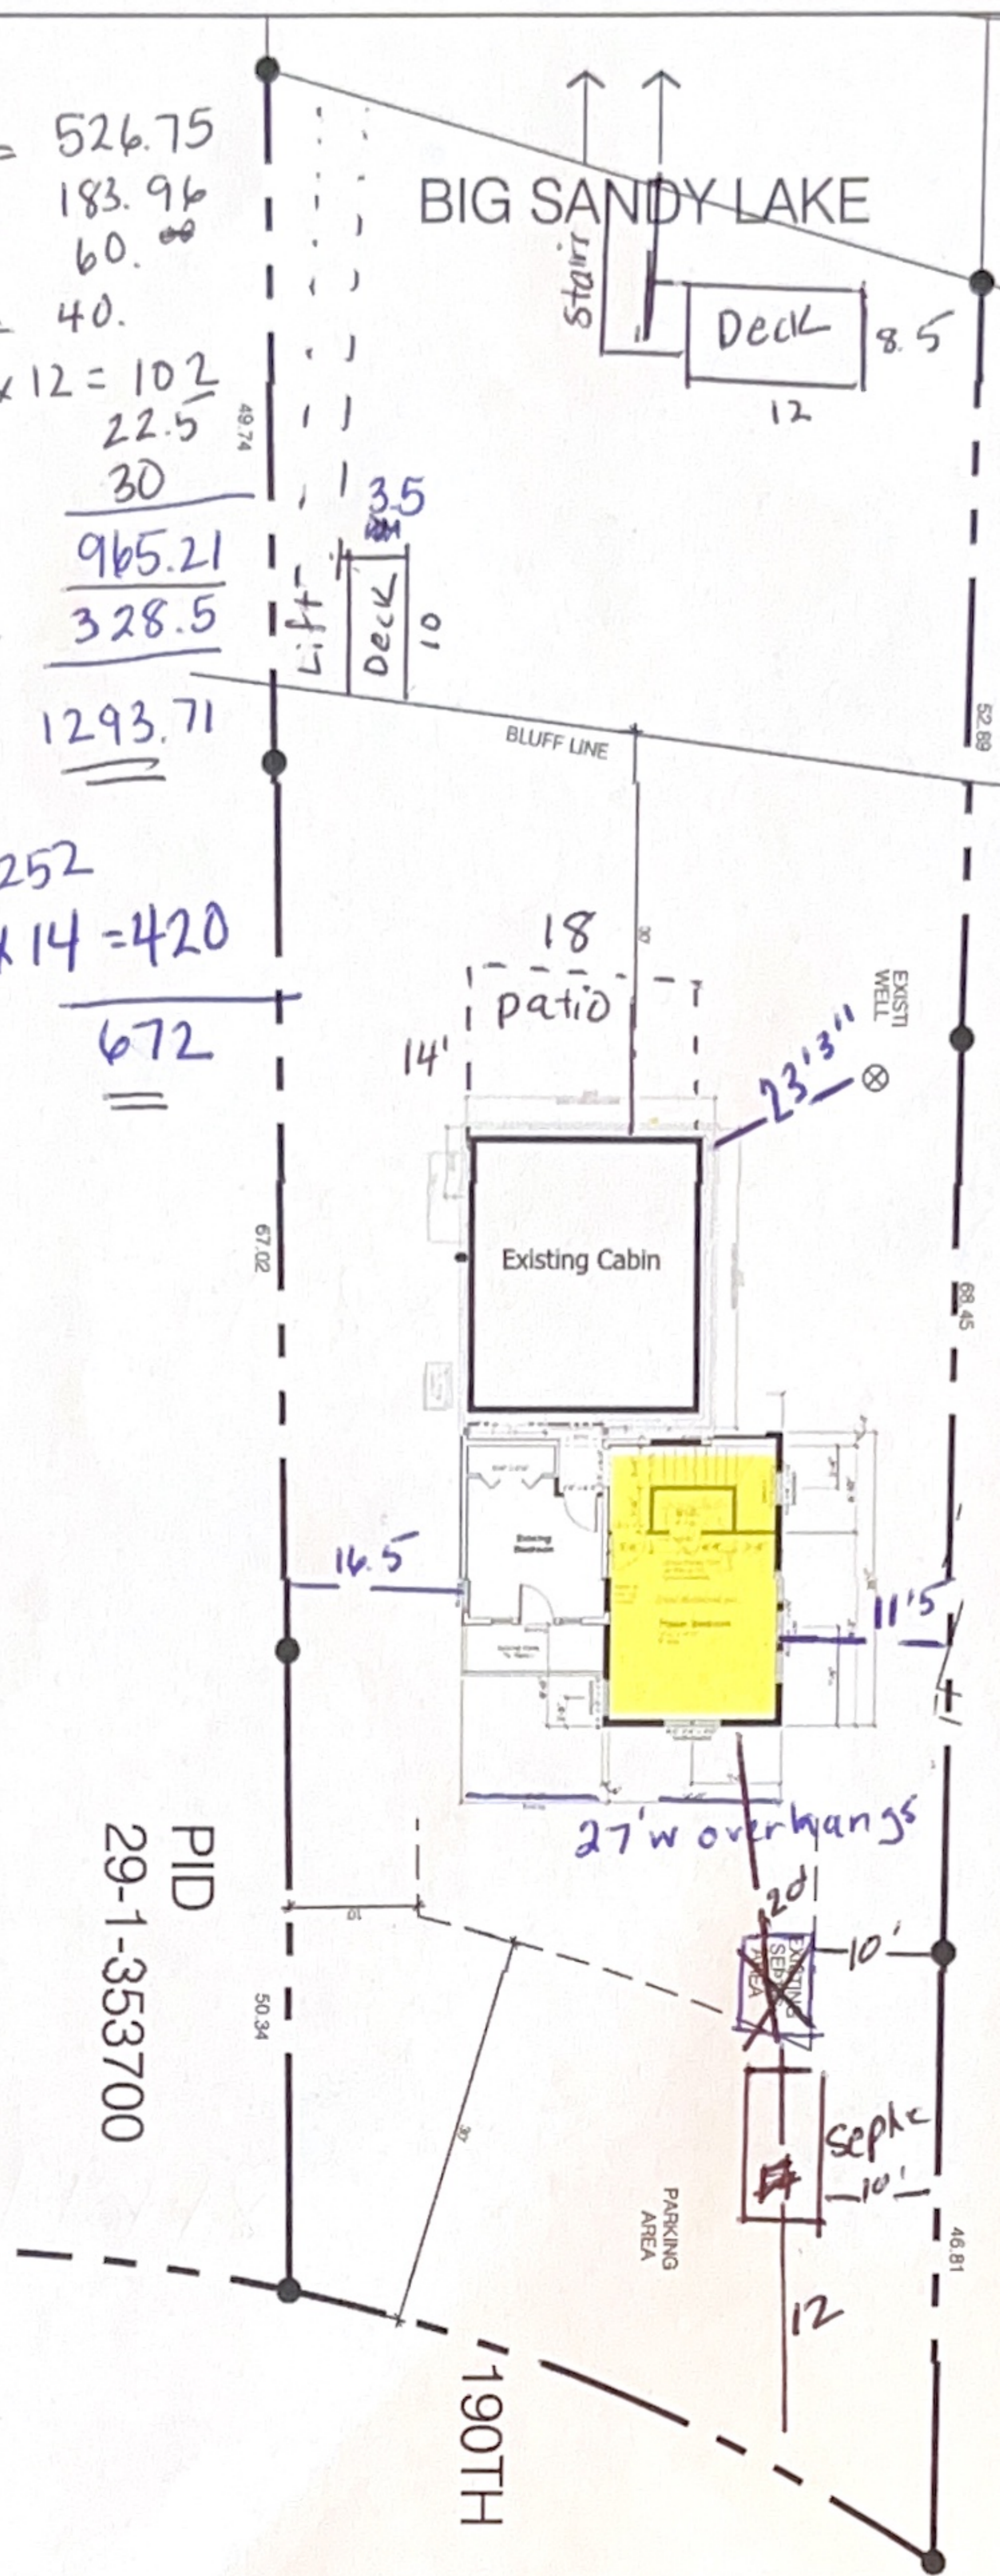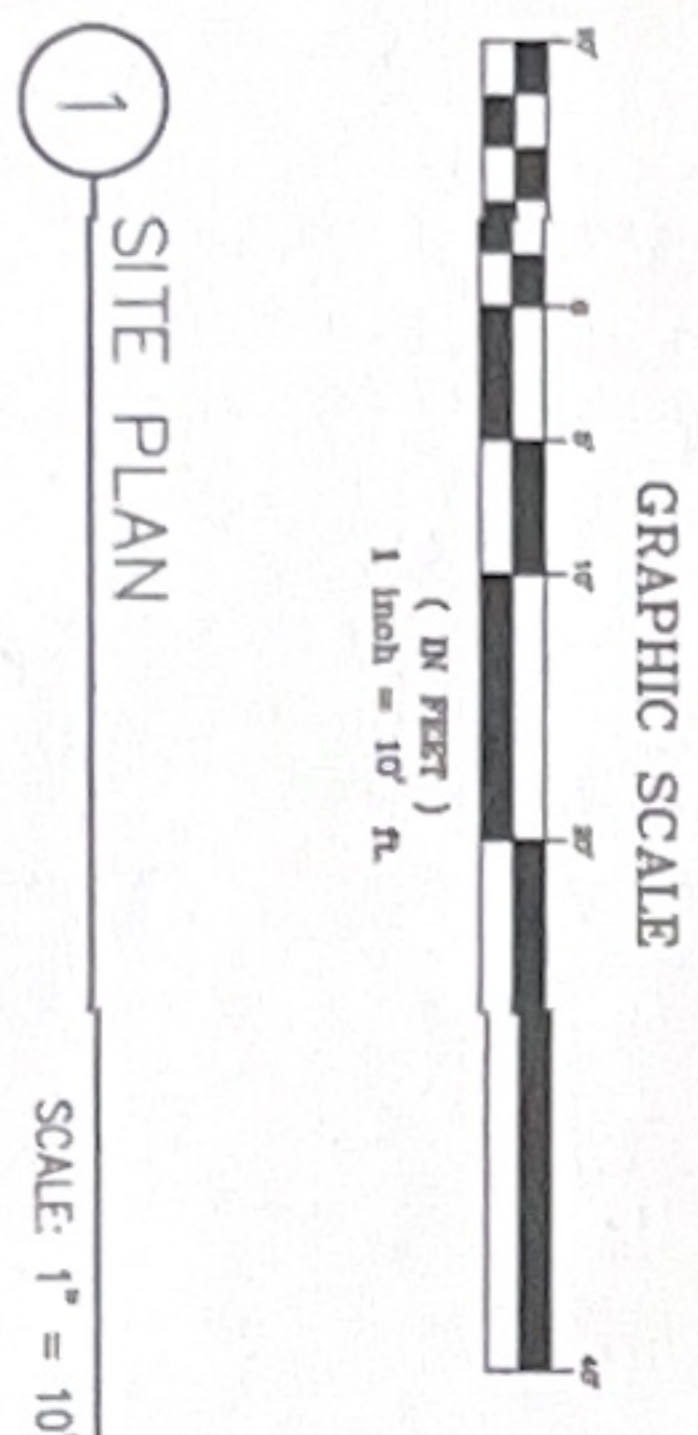

BRUNS CABIN ADDITION

MC GREGOR, MN
 BIG SANDY LAKE
 BELL HORN BAY
 ATKIN COUNTY

Project Title
 BRUNS CABIN ADDITION
 51439 190TH PLACE
 MC GREGOR, MN 55760
 BIG SANDY LAKE
 BELL HORN BAY

OWNER - JULIE BRUNS

NOT FOR CONSTRUCTION



ALL DIMENSIONS AND
 CONDITIONS TO BE
 VERIFIED BY OTHERS

Issue Date 3/20/17 PRELIM

Sheet Title
 SITE PLAN

Sheet Number
 AS1