


150'

Lot 5 Owl Ave

268'

42

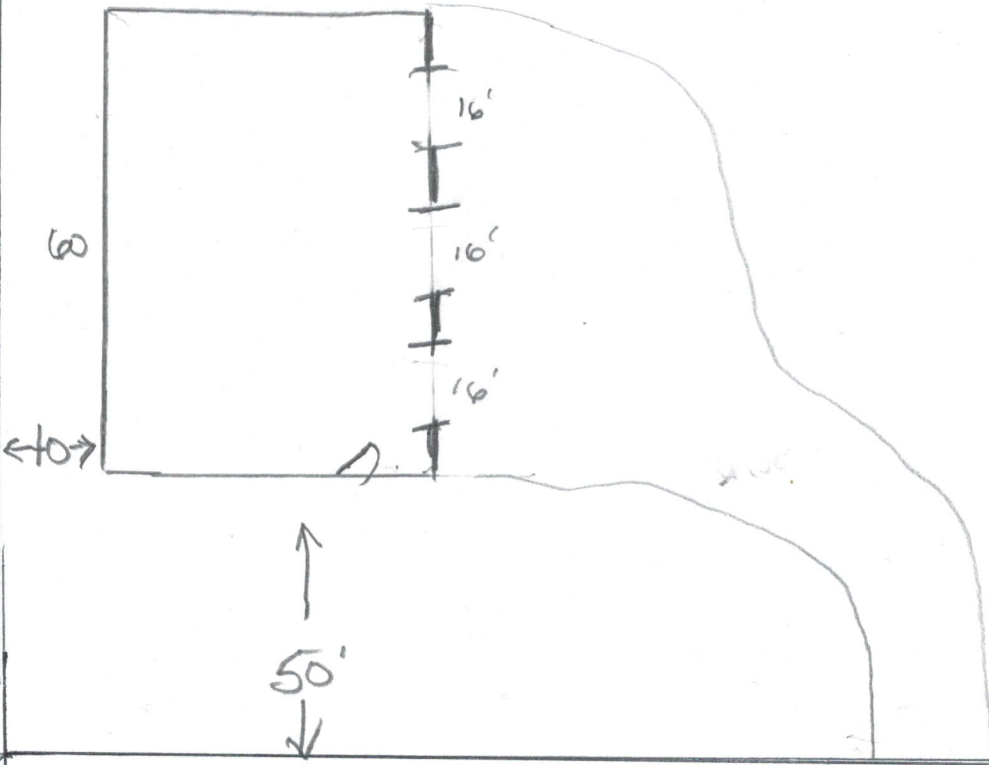

60

←10→

16'

↑
50'
↓

Road