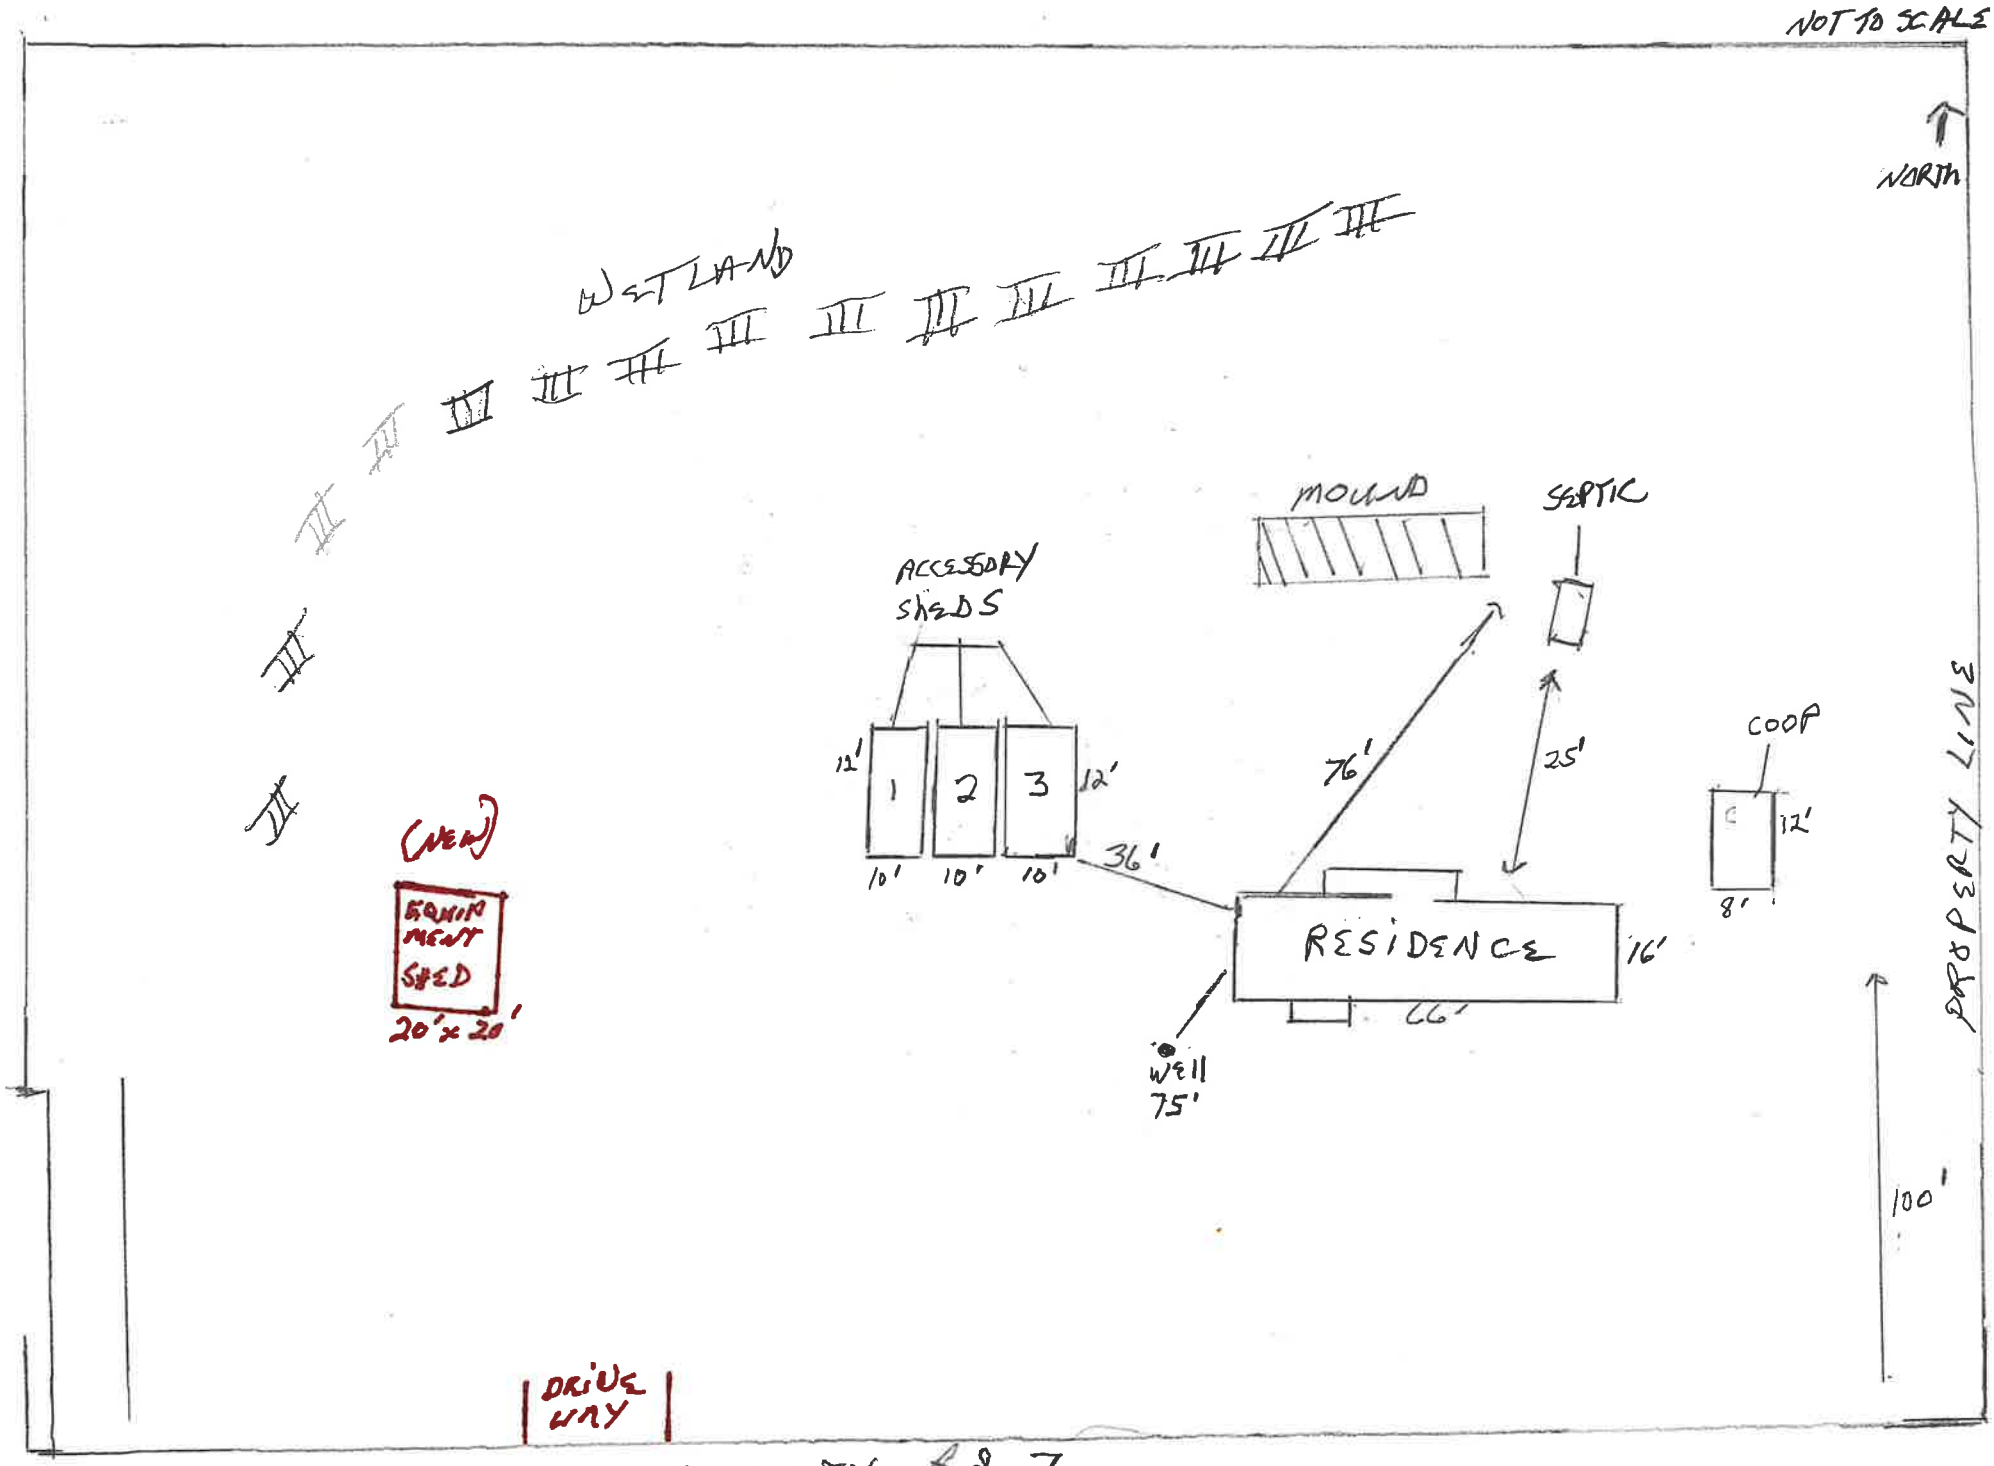
NOT TO SCALE
NORTH
WETLAND
MOUND
SEPTIC
ACCESSORY SHEDS
1
2
3
12'
12'
10'
10'
10'
36'
76'
25'
COOP
12'
8'
RESIDENCE
16'
66'
WELL
75'
PROPERTY LINE
100'
(NEW)
EQUIPMENT SHED
20' x 20'
DRIVE WAY
COUNTY Rd 7