

FARLEY SEWER SYSTEMS

SEWER DESIGN & INSTALLATION

JAROLD R. FARLEY

P.O. Box 472
McGregor, MN 55760

Bus. Lic. No. L1919
Reg. No. 4744


218-839-4737 cell

This is the Farthest
North 5 acres of 35-0-017800
which is currently 13 Acre.

Sewer sites For
a Lot Line adjustment

Parcel A

No Well on Parcel A

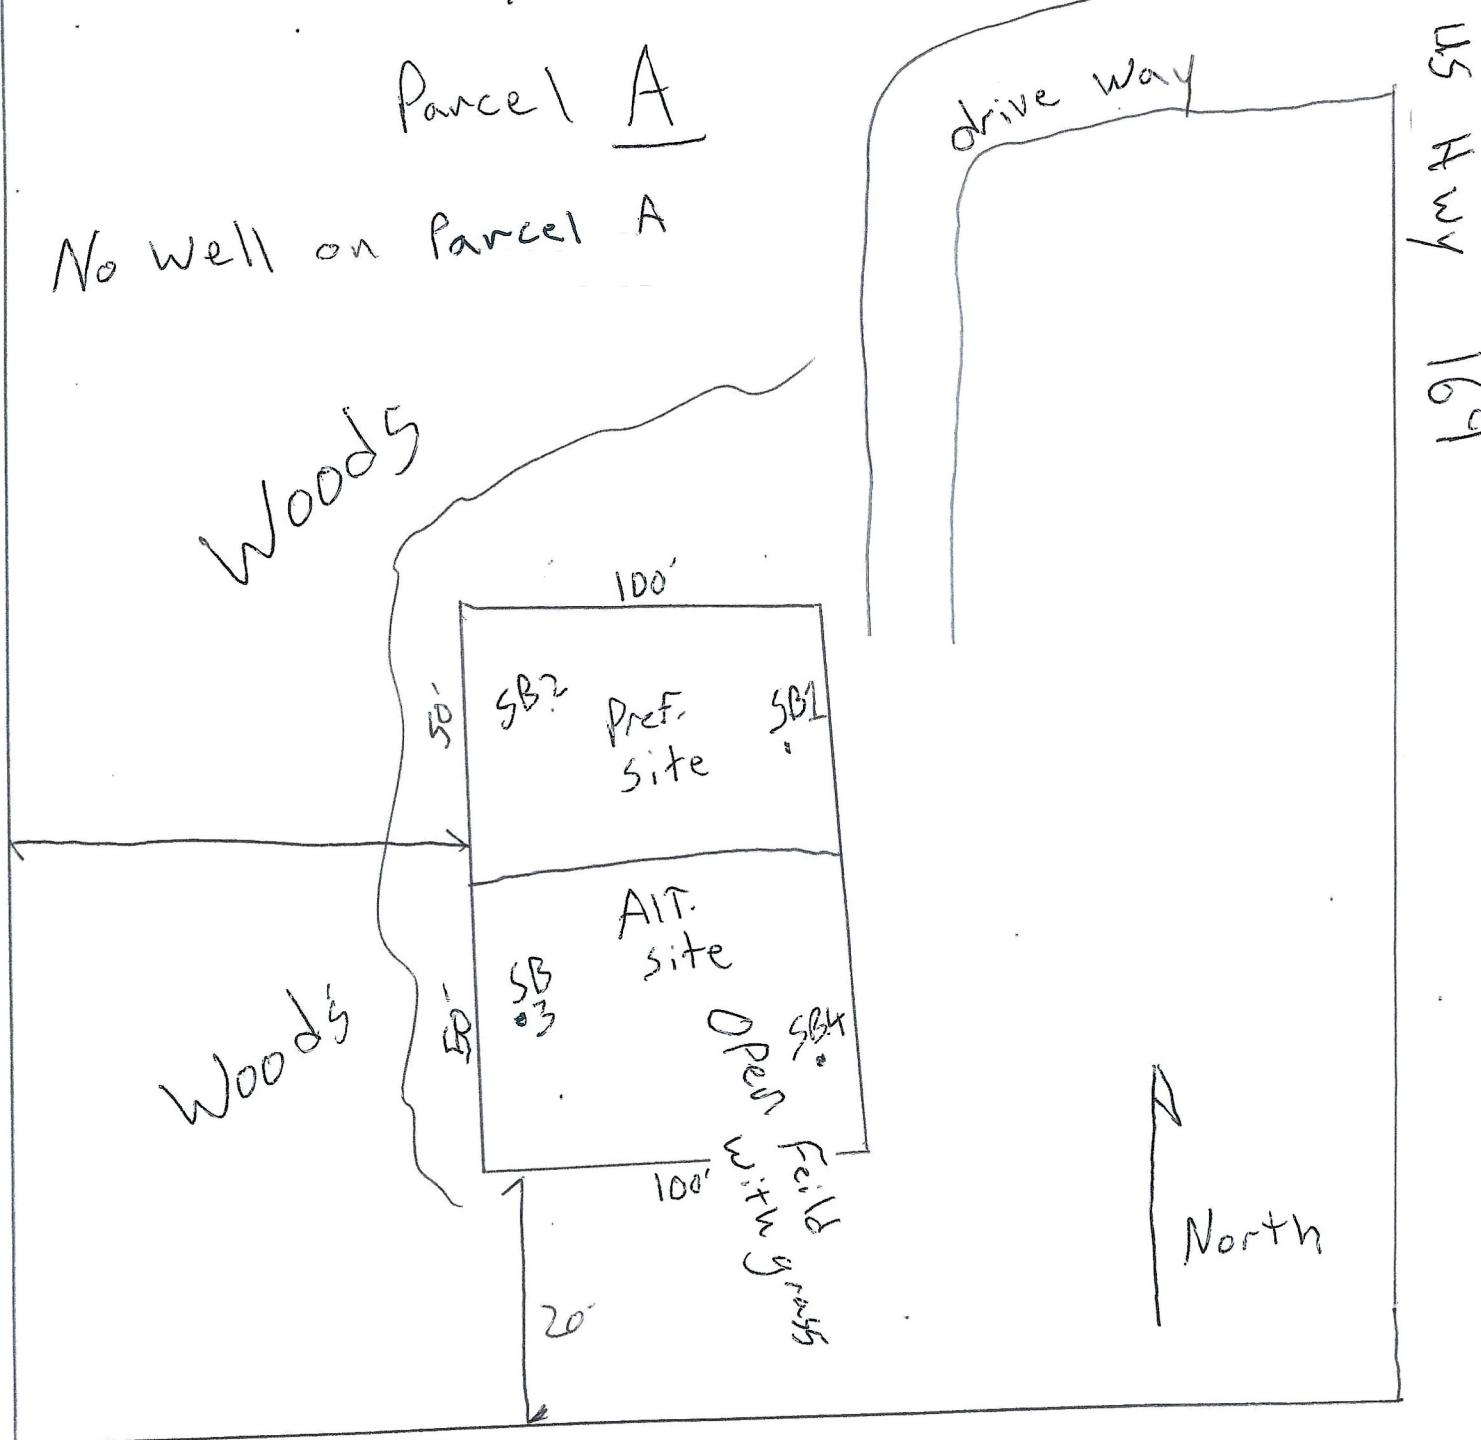

Sewer Site's For the Furthest North Parcel

Soil Observation Log

Parcel A

Owner Information	
Property Owner / project:	Dennis & Rose Petrick
Property Address / PID:	50417 US Hwy. 169, Palisade MN.
Date	5/2/2024

Soil Survey Information						<input type="checkbox"/> refer to attached soil survey
Parent matl's:	<input checked="" type="checkbox"/> Till	<input type="checkbox"/> Outwash	<input type="checkbox"/> Lacustrine	<input type="checkbox"/> Alluvium	<input type="checkbox"/> Organic	<input type="checkbox"/> Bedrock
landscape position:	<input checked="" type="checkbox"/> Summit	<input type="checkbox"/> Shoulder	<input type="checkbox"/> Side slope	<input type="checkbox"/> Toe slope		
soil survey map units:	<u> </u>		slope <u>0-1</u> %	direction- <u>downhill</u>		

Soil Log #1							
Depth (in)	Texture	fragment %	Elevation _____	redox color	Depth to SHWT _____	consistence	grade
0-5"	top soil loam	<35 35 - 50 >50	10 yr 3/2		loose friable firm rigid	loose weak moderate strong	single grain granular blocky prismatic platy massive
5-14"	sandy loam	<35 35 - 50 >50	10 yr 4/6		loose friable firm rigid	loose weak moderate strong	single grain granular blocky prismatic platy massive
14"		<35 35 - 50 >50		7.5 yr 4/6	loose friable firm rigid	loose weak moderate strong	single grain granular blocky prismatic platy massive
		<35 35 - 50 >50			loose friable firm rigid	loose weak moderate strong	single grain granular blocky prismatic platy massive
		<35 35 - 50 >50			loose friable firm rigid	loose weak moderate strong	single grain granular blocky prismatic platy massive
Comments:							

50417 US Hwy. 169, Palisade MN.

Soil Log #2

Depth (in)	Texture	fragment %	matrix color	redox color	Depth to SHWT		
					consistence	grade	shape
0-5"	top soil	<35 35 - 50 >50	10 yr 3/2		loose friable firm rigid	loose weak moderate strong	single grain granular blocky prismatic platy massive
5-13"	sandy loam	<35 35 - 50 >50	10 yr 4/6		loose friable firm rigid	loose weak moderate strong	single grain granular blocky prismatic platy massive
13"		<35 35 - 50 >50		7.5 yr 4/6	loose friable firm rigid	loose weak moderate strong	single grain granular blocky prismatic platy massive
		<35 35 - 50 >50			loose friable firm rigid	loose weak moderate strong	single grain granular blocky prismatic platy massive
		<35 35 - 50 >50			loose friable firm rigid	loose weak moderate strong	single grain granular blocky prismatic platy massive

50417 US Hwy. 169, Palisade MN.

Soil Log #3

Depth (in)	Texture	fragment %	matrix color	redox color	Depth to SHWT		
					consistence	grade	shape
0-6"	top soil	<35 35 - 50 >50	10 yr 3/2		loose friable firm rigid	loose weak moderate strong	single grain granular blocky prismatic platy massive
6-14"	sandy loam	<35 35 - 50 >50	10 yr 4/4		loose friable firm rigid	loose weak moderate strong	single grain granular blocky prismatic platy massive
14"		<35 35 - 50 >50		7.5 yr 4/6	loose friable firm rigid	loose weak moderate strong	single grain granular blocky prismatic platy massive
		<35 35 - 50 >50			loose friable firm rigid	loose weak moderate strong	single grain granular blocky prismatic platy massive
		<35 35 - 50 >50			loose friable firm rigid	loose weak moderate strong	single grain granular blocky prismatic platy massive

I hereby certify this work was completed in accordance with MN 7080 and any local req's.

Jarold R. Farley

Designer Signature

Farley sewer systems

Company

L-1919

License #

LUG soil verify Signature

+

Lug media elev/depth Signature

= Soil Separation Report

50417 US Hwy. 169, Palisade MN.

Soil Log #4

		<input type="checkbox"/> Boring	<input type="checkbox"/> Pit	Elevation _____	Depth to SHWT _____			
Depth (in)	Texture	fragment %	matrix color	redox color	consistence	grade	shape	
0-4"	top soil	<35 35 - 50 >50	10 yr 3/2		loose friable firm rigid	loose weak moderate strong	single grain granular blocky prismatic platy massive	
4-13"	sandy loam	<35 35 - 50 >50	10 yr 4/4		loose friable firm rigid	loose weak moderate strong	single grain granular blocky prismatic platy massive	
13"		<35 35 - 50 >50		7.5 yr 4/6	loose friable firm rigid	loose weak moderate strong	single grain granular blocky prismatic platy massive	
		<35 35 - 50 >50			loose friable firm rigid	loose weak moderate strong	single grain granular blocky prismatic platy massive	
		<35 35 - 50 >50			loose friable firm rigid	loose weak moderate strong	single grain granular blocky prismatic platy massive	

50417 US Hwy. 169, Palisade MN.

Soil Log #5

		<input type="checkbox"/> Boring	<input type="checkbox"/> Pit	Elevation _____	Depth to SHWT _____			
Depth (in)	Texture	fragment %	matrix color	redox color	consistence	grade	shape	
		<35 35 - 50 >50			loose friable firm rigid	loose weak moderate strong	single grain granular blocky prismatic platy massive	
		<35 35 - 50 >50			loose friable firm rigid	loose weak moderate strong	single grain granular blocky prismatic platy massive	
		<35 35 - 50 >50			loose friable firm rigid	loose weak moderate strong	single grain granular blocky prismatic platy massive	
		<35 35 - 50 >50			loose friable firm rigid	loose weak moderate strong	single grain granular blocky prismatic platy massive	
		<35 35 - 50 >50			loose friable firm rigid	loose weak moderate strong	single grain granular blocky prismatic platy massive	

I hereby certify this work was completed in accordance with MN 7080 and any local req's.

Jarold R. Farley
Designer SignatureFarley sewer systems
CompanyL-1919
License #

FARLEY SEWER SYSTEMS


SEWER DESIGN & INSTALLATION

JAROLD R. FARLEY

P.O. Box 472
McGregor, MN 55760

Bus. Lic. No. L1919
Reg. No. 4744

218-839-4737 cell

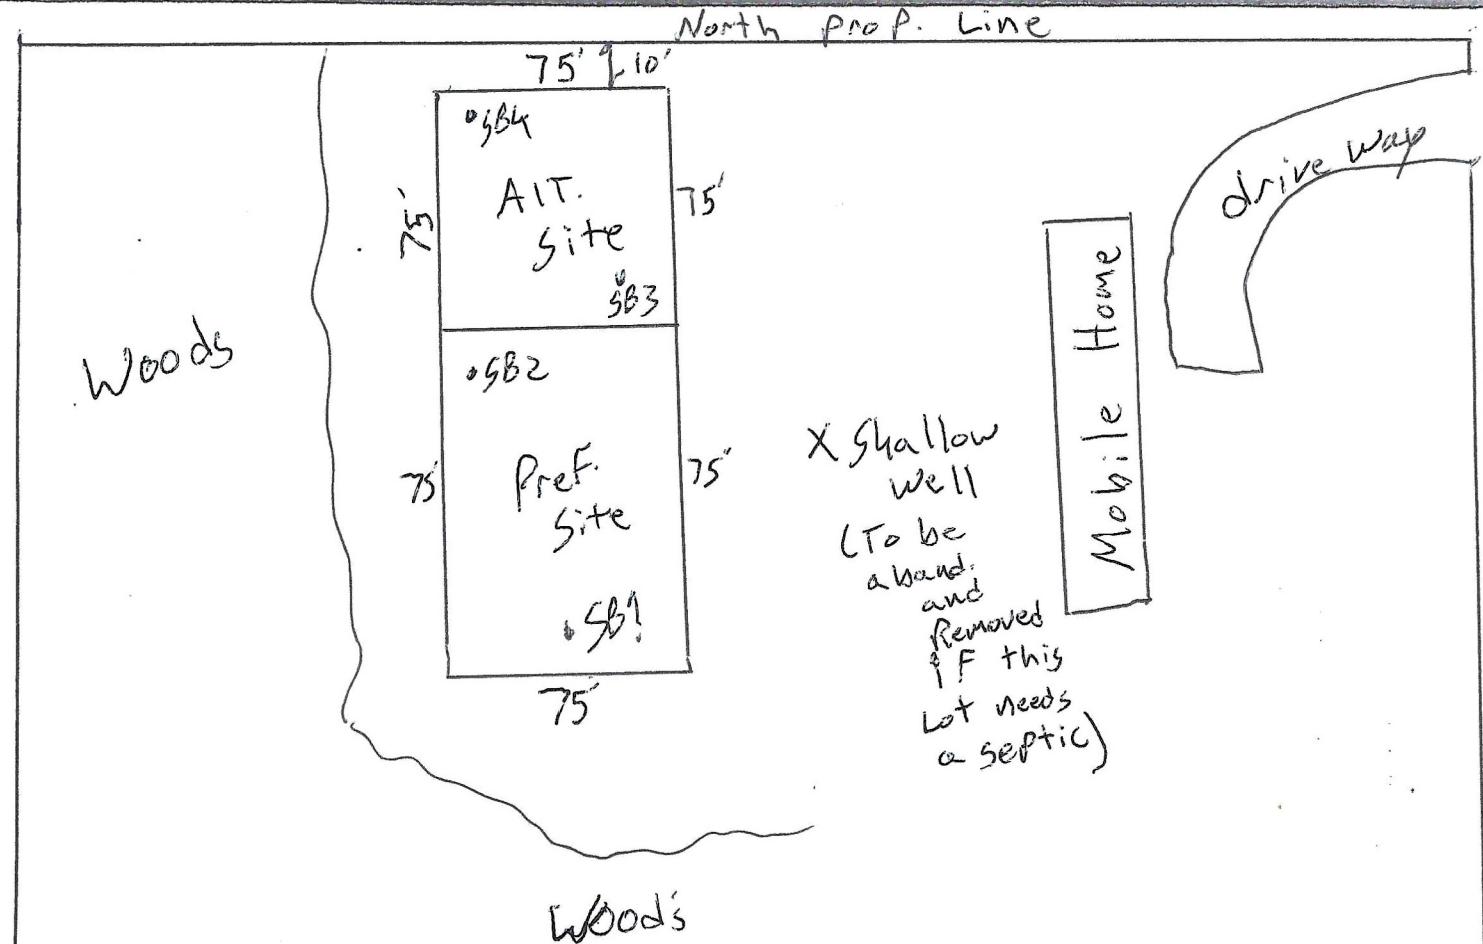

Parcel B

The South and Remaining Parcel
of 35-0-017800

Sewer Sites For the Remaining South Portion of 350-0178000

Soil Observation Log

Parcel B

Owner Information	
Property Owner / project:	Dennis & Rose Petrick
Property Address / PID:	50417 US Hwy. 169, Palisade MN.
Date	5/2/2024

Soil Survey Information						<input type="checkbox"/> refer to attached soil survey
Parent matl's:	<input checked="" type="checkbox"/> Till	<input type="checkbox"/> Outwash	<input type="checkbox"/> Lacustrine	<input type="checkbox"/> Alluvium	<input type="checkbox"/> Organic	<input type="checkbox"/> Bedrock
landscape position:	<input checked="" type="checkbox"/> Summit	<input type="checkbox"/> Shoulder	<input type="checkbox"/> Side slope	<input type="checkbox"/> Toe slope		
soil survey map units:	_____		slope 0-1 %	direction- downhill		

Soil Log #1							
Depth (in)	Texture	fragment %	Elevation _____ matrix color	redox color	Depth to SHWT _____ consistence	grade	shape
0-5"	top soil loam	<35 35-50 >50	10 yr 3/2		loose friable firm rigid	loose weak moderate strong	single grain granular blocky prismatic platy massive
5-14"	sandy loam	<35 35-50 >50	10 yr 4/6		loose friable firm rigid	loose weak moderate strong	single grain granular blocky prismatic platy massive
		<35 35 - 50 >50			loose friable firm rigid	loose weak moderate strong	single grain granular blocky prismatic platy massive
		<35 35 - 50 >50			loose friable firm rigid	loose weak moderate strong	single grain granular blocky prismatic platy massive
		<35 35 - 50 >50			loose friable firm rigid	loose weak moderate strong	single grain granular blocky prismatic platy massive

50417 US Hwy. 169, Palisade MN.

Soil Log #2

Depth (in)	Texture	fragment %	Elevation	redox color	consistence	Depth to SHWT	grade	shape
			matrix color					
0-5"	top soil	<35 35 - 50 >50	10 yr 3/2		loose friable firm rigid	loose weak moderate strong	single grain granular blocky prismatic platy massive	
5-13"	sandy loam	<35 35 - 50 >50	10 yr 4/6		loose friable firm rigid	loose weak moderate strong	single grain granular blocky prismatic platy massive	
		<35 35 - 50 >50			loose friable firm rigid	loose weak moderate strong	single grain granular blocky prismatic platy massive	
		<35 35 - 50 >50			loose friable firm rigid	loose weak moderate strong	single grain granular blocky prismatic platy massive	
		<35 35 - 50 >50			loose friable firm rigid	loose weak moderate strong	single grain granular blocky prismatic platy massive	

50417 US Hwy. 169, Palisade MN.

Soil Log #3

Depth (in)	Texture	fragment %	Elevation	redox color	consistence	Depth to SHWT	grade	shape
			matrix color					
0-4"	top soil	<35 35 - 50 >50	10 yr 3/2		loose friable firm rigid	loose weak moderate strong	single grain granular blocky prismatic platy massive	
4-16"	sandy loam	<35 35 - 50 >50	10 yr 4/4		loose friable firm rigid	loose weak moderate strong	single grain granular blocky prismatic platy massive	
		<35 35 - 50 >50			loose friable firm rigid	loose weak moderate strong	single grain granular blocky prismatic platy massive	
		<35 35 - 50 >50			loose friable firm rigid	loose weak moderate strong	single grain granular blocky prismatic platy massive	
		<35 35 - 50 >50			loose friable firm rigid	loose weak moderate strong	single grain granular blocky prismatic platy massive	

I hereby certify this work was completed in accordance with MN 7080 and any local req's.

Jarold R. Farley

Designer Signature

Farley sewer systems

Company

L-1919

License #

LUG soil verify Signature

+

Lug media elev/depth Signature

= Soil Separation Report

50417 US Hwy. 169, Palisade MN.

Soil Log #4

Depth (in)	Texture	fragment %	Elevation		Depth to SHWT			
			matrix color	redox color	consistence	grade	shape	
0-5"	top soil	<35 35 - 50 >50	10 yr 3/2		loose friable firm rigid	loose weak moderate strong	single grain granular blocky prismatic platy massive	
5-15"	sandy loam	<35 35 - 50 >50	10 yr 4/4		loose friable firm rigid	loose weak moderate strong	single grain granular blocky prismatic platy massive	
		<35 35 - 50 >50			loose friable firm rigid	loose weak moderate strong	single grain granular blocky prismatic platy massive	
		<35 35 - 50 >50			loose friable firm rigid	loose weak moderate strong	single grain granular blocky prismatic platy massive	
		<35 35 - 50 >50			loose friable firm rigid	loose weak moderate strong	single grain granular blocky prismatic platy massive	

50417 US Hwy. 169, Palisade MN.

Soil Log #5

Depth (in)	Texture	fragment %	Elevation		Depth to SHWT			
			matrix color	redox color	consistence	grade	shape	
		<35 35 - 50 >50			loose firm rigid	loose moderate strong	single grain granular blocky prismatic platy massive	
		<35 35 - 50 >50			loose friable firm rigid	loose weak moderate strong	single grain granular blocky prismatic platy massive	
		<35 35 - 50 >50			loose friable firm rigid	loose weak moderate strong	single grain granular blocky prismatic platy massive	
		<35 35 - 50 >50			loose friable firm rigid	loose weak moderate strong	single grain granular blocky prismatic platy massive	
		<35 35 - 50 >50			loose friable firm rigid	loose weak moderate strong	single grain granular blocky prismatic platy massive	

I hereby certify this work was completed in accordance with MN 7080 and any local req's.

Jarold R. Farley
Designer SignatureFarley sewer systems
CompanyL-1919
License #