


LAKE MINNEW

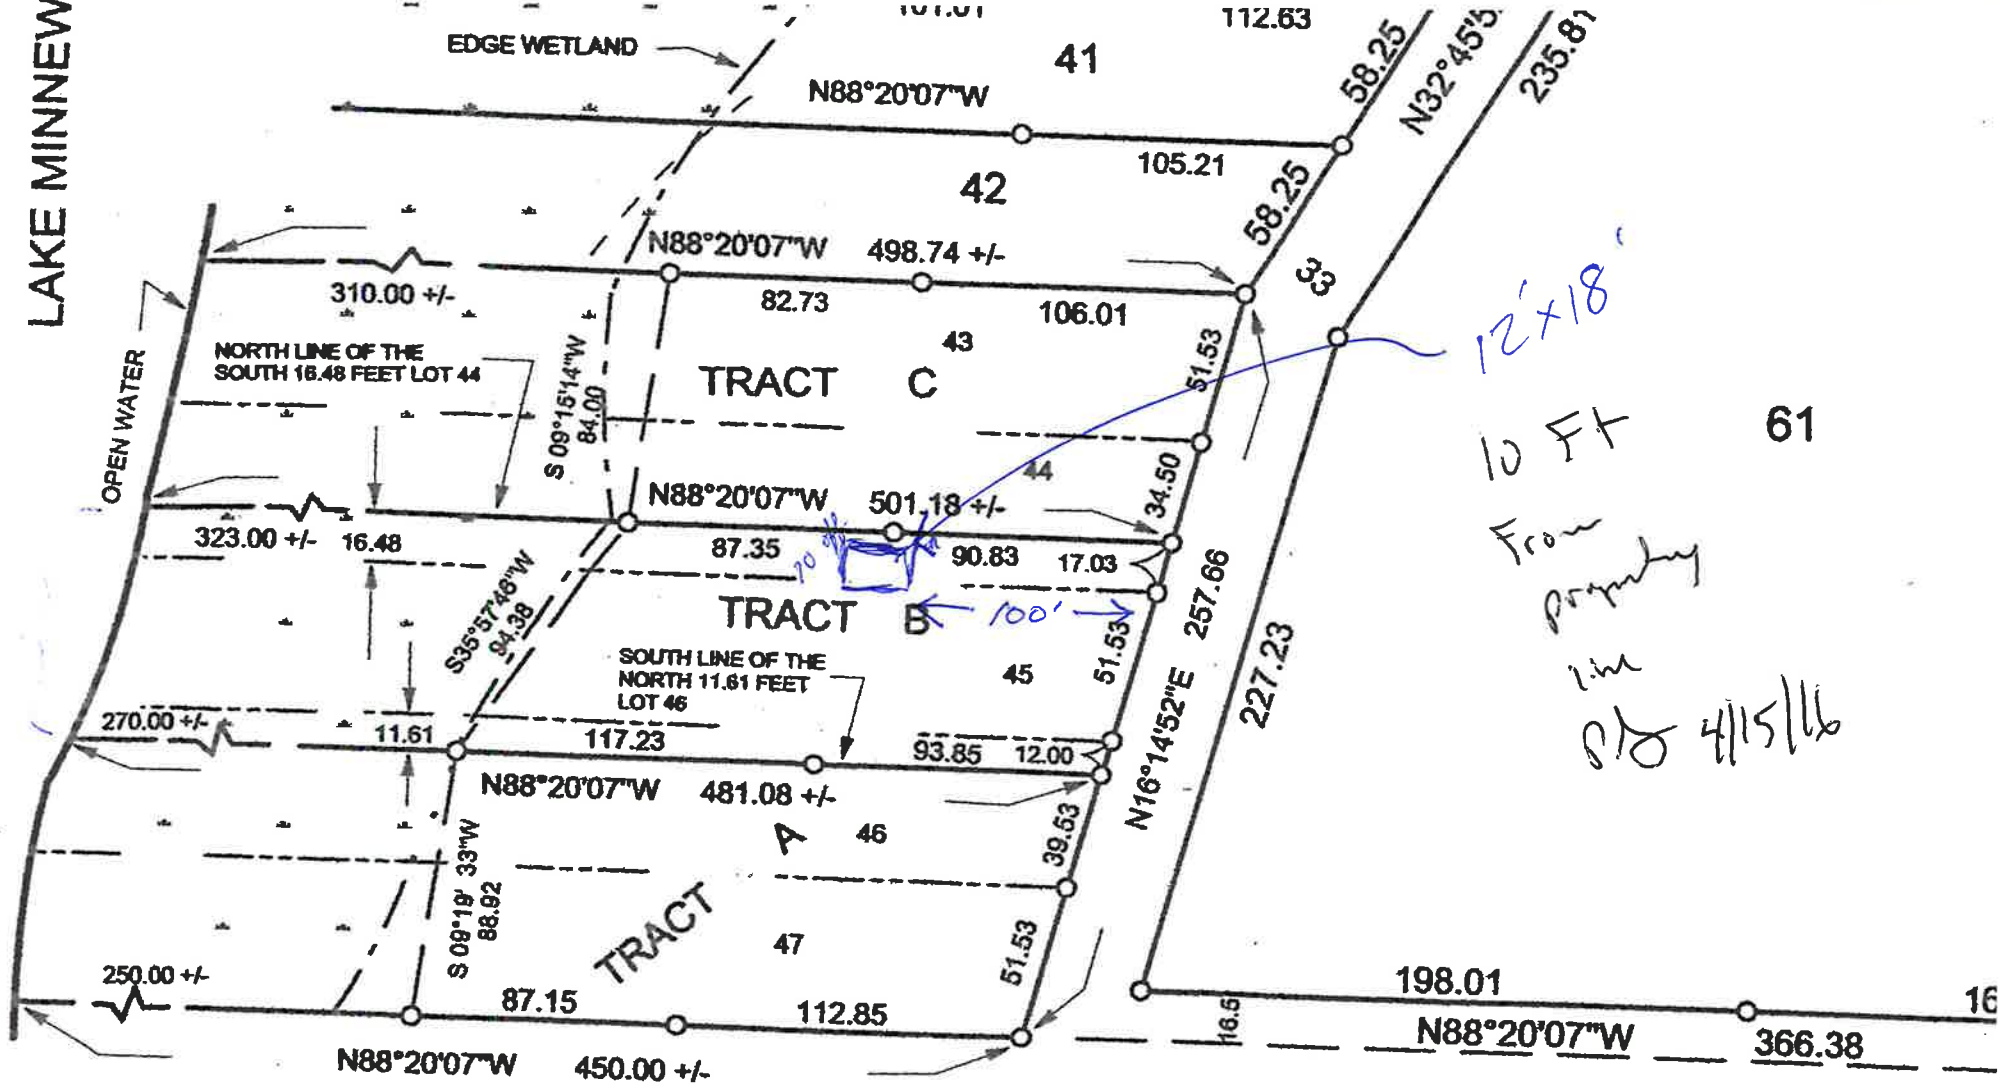

NOTE: OPEN WATER NOT LOCATED

MARVIN KOHOUT