


Site Evaluation Map

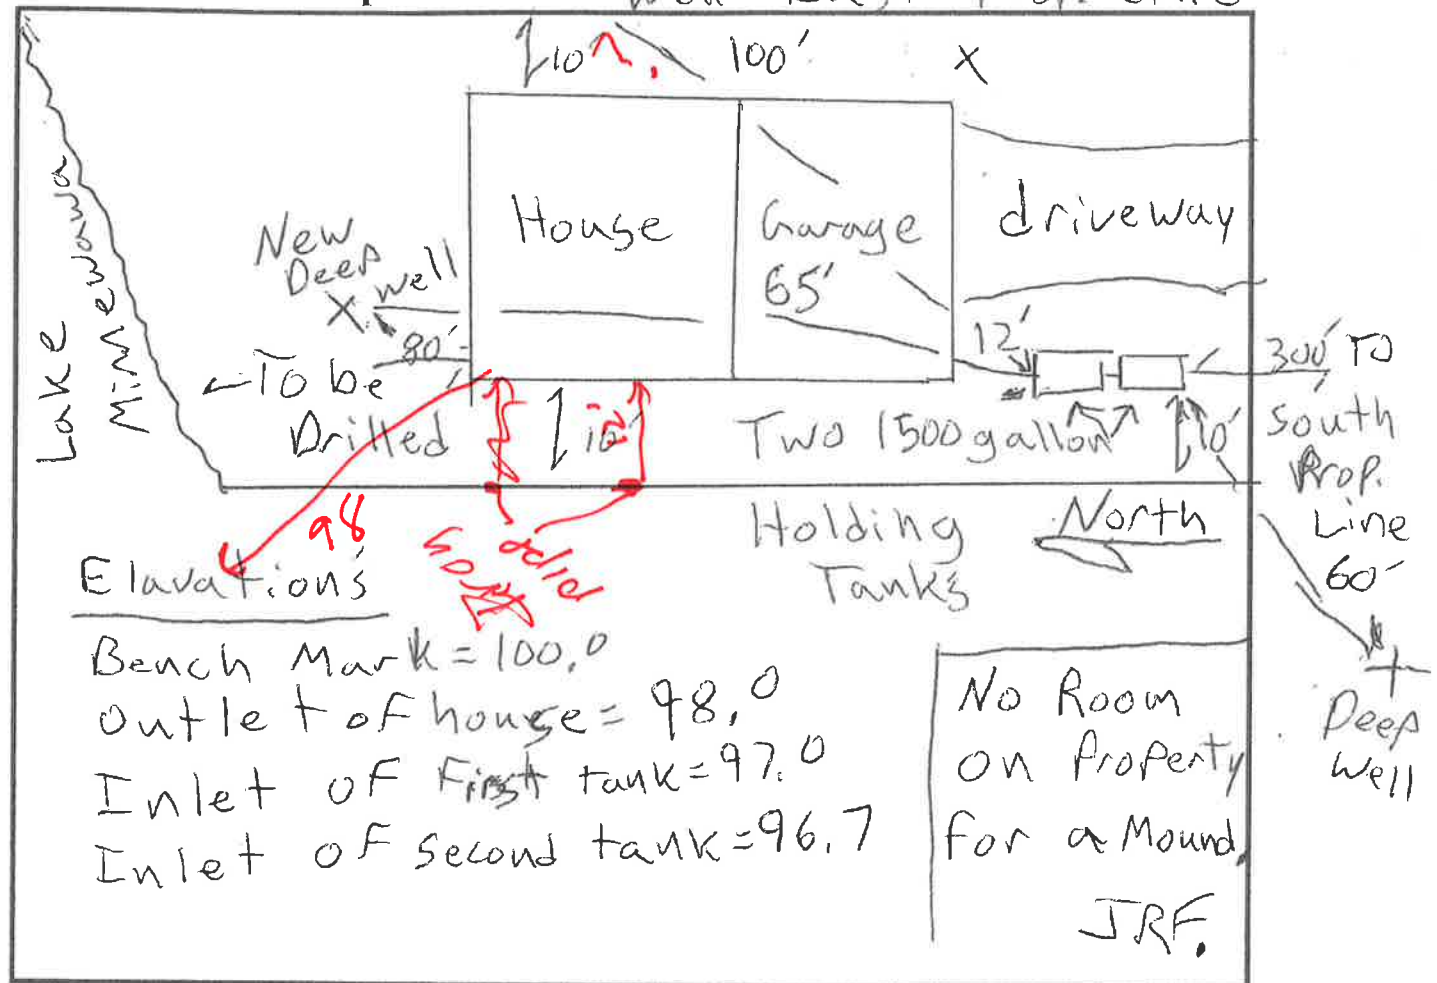

List any construction issues: _____

Mapping Checklist

Map scale: _____ indicate north _____ show slope _____ % direction _____

Locate

- | | | |
|---|---|---|
| <input type="checkbox"/> lot dimensions/property lines | Easements | Setbacks |
| <input type="checkbox"/> dwellings and other improvements | <input type="checkbox"/> phone | <input type="checkbox"/> building |
| <input type="checkbox"/> existing and/or proposed system(s) | <input type="checkbox"/> electric | <input type="checkbox"/> all water wells within 100ft |
| <input type="checkbox"/> replacement area | <input type="checkbox"/> gas | <input type="checkbox"/> pressure pipe |
| <input type="checkbox"/> unsuitable area(s) | | <input type="checkbox"/> water suction pipe |
| <input type="checkbox"/> public water supply wells | Elevations | <input type="checkbox"/> streams, lakes, rivers |
| <input type="checkbox"/> pumping access | <input type="checkbox"/> borings | <input type="checkbox"/> floodway and fringe |
| <input type="checkbox"/> inner wellhead zone | <input type="checkbox"/> benchmark | |
| | <input type="checkbox"/> perc tests | |
| | <input type="checkbox"/> horiz&vert reference pts | |

I hereby certify this work has been completed in accordance with all applicable ordinances, rules and laws.

[Signature] (signature)

4/13/2016 (date)

L-1919

(license #)

218-839-4737

(phone number)