


AITKIN COUNTY BUILDING PERMIT SITE PLAN

Please indicate the location of: Wells, well setback to system components, buildings, septic system components, reserved septic system area, property lines, waterways, and buried lines. Include size, length, and appropriate distances from fixed reference points. Provide a North directional arrow!

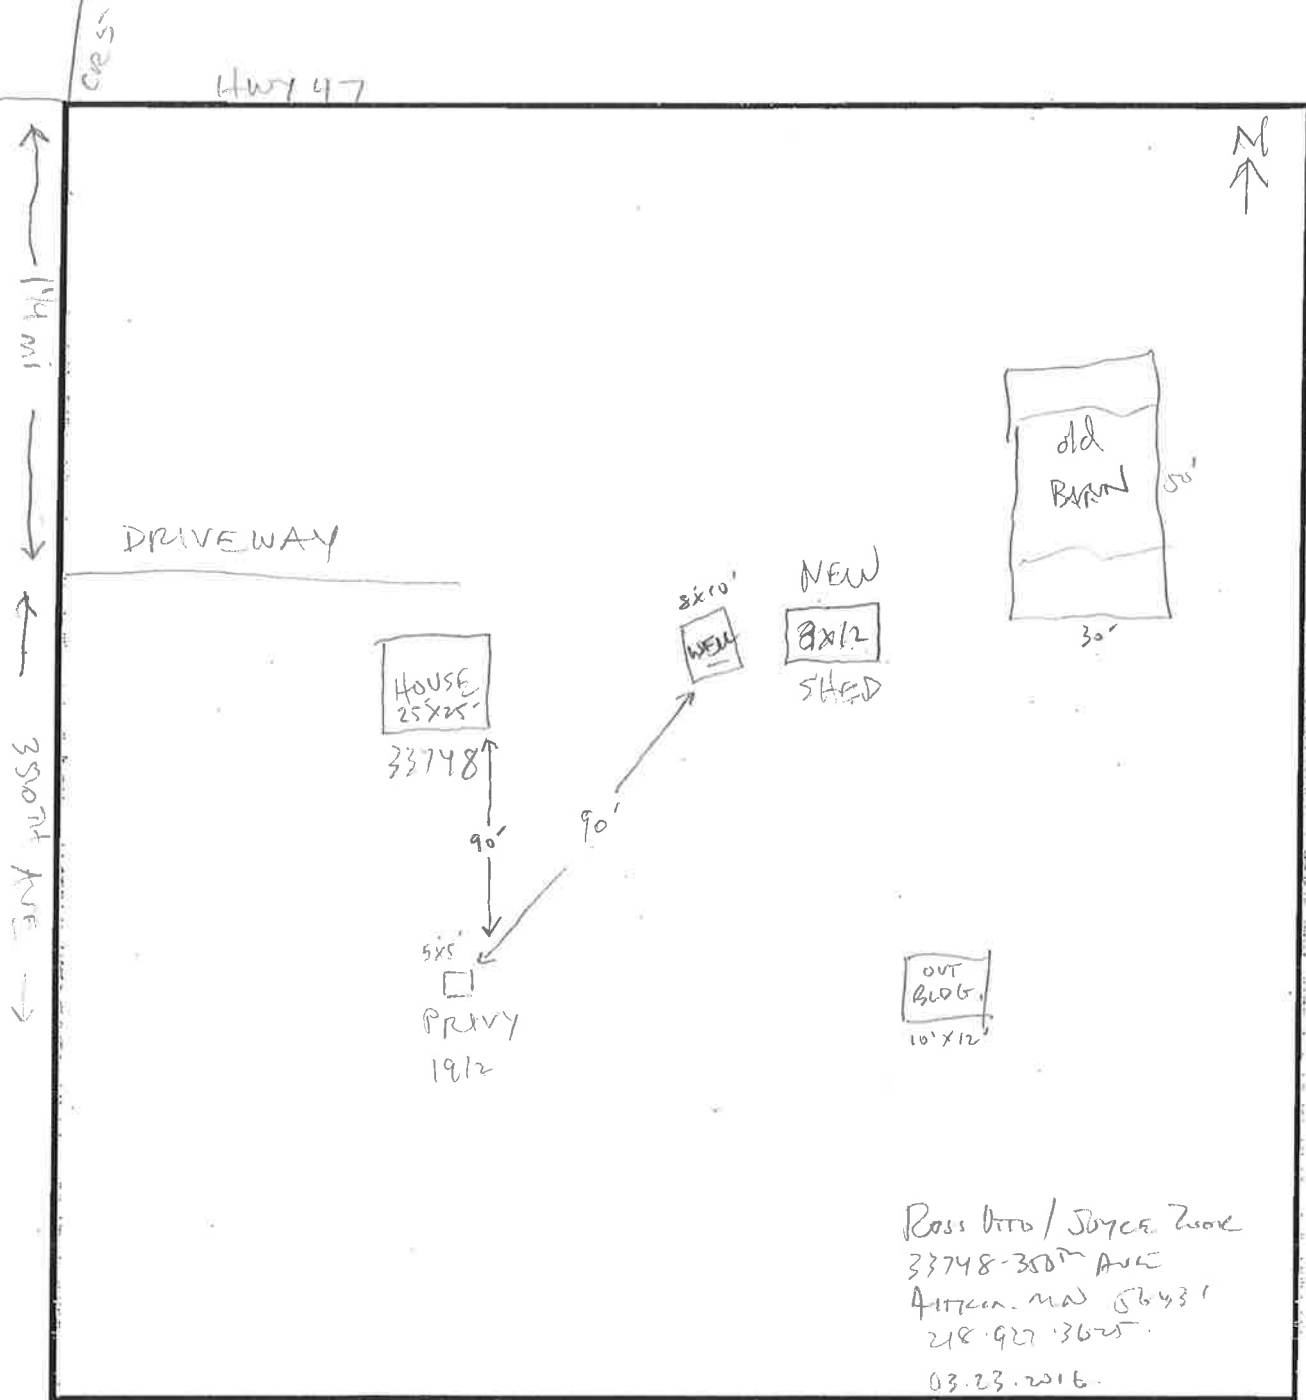

Ross Otto / Joyce Zook
33748-3500th AVE
AITKIN, MN 56431
218-927-3625
03.23.2016