

FIELD EVALUATION SHEET

NAME Michael Haley PERMIT # _____
 PARCEL # _____ TWP _____ SECTION _____

CHECK THE FOLLOWING PRIOR TO INSPECTION

 _____ NAME OF SITE EVALUATOR
 _____ NAME OF DESIGNER
 _____ NAME OF INSTALLER

 _____ LOT OF RECORD BEFORE 1-21-92 (SL) IR 1-10-95 (NSL), IF NO, ALT. SITE?
 _____ SITE PLAN WITH SETBACK DISTANCES AND DIMENSIONS
 _____ ARE ISTS SITES PROTECTED FROM DAMAGE? IF NOT, WHEN _____
 _____ DESIGN _____ PERC TESTS _____ SOIL BORINGS, 2 PER SITE
 _____ NUMBER OF BEDROOMS (INCLUDE POTENTIAL)
 _____ CROSS SECTION SHEET _____ TRENCH DESIGN SHEET
 _____ MOUND DESIGN SHEET _____ OTHER OR PERFORM.
 _____ PRESSURE DISTRIBUTION SHEET _____ PUMP CALC. TEST
 _____ WATER USE CALCULATIONS _____
 _____ GARBAGE DISPOSAL _____ HOT TUB
 _____ EASEMENTS ON LOT, IS ROAD PUBLIC OR PRIVATE SEE DEED/PLAT
 _____ NATURAL LANDSCAPE PROTECTION PLAN

STAKING: BUILDINGS _____, DRAINFIELD _____, BORINGS _____, WELL _____
 BUILDING SETBACKS: ROAD _____, SIDE _____, REAR _____, BLUFF _____,
 LAKE/RIVER _____

COMPLETE DURING SITE EVALUATION

 _____ BUILDINGS STAKED _____ DRAINFIELD STAKED _____ BORINGS STAKED
 _____ WELL STAKED

SETBACKS (MEASURE DISTANCE)

FLOOD PLAIN
 WETLANDS
 LAKE, RIVER, PROTECTED WATERS
 ROAD RIGHT OF WAY
 BLUFF
 SIDE LOT LINE
 REAR LOT LINE
 HOUSE OR OTHER STRUCTURE
 WELL
 EASEMENTS
 NEIGHBORING WELL (S) TO ISTS
 DRAINFIELD AREA DISTURBED _____

<u>DRAINFIELD</u>	<u>HOUSE</u>
YES/NO	YES/NO
YES/NO /	YES/NO
> 200	120+
40' <i>border</i>	575
11'	10'
	250
(1)	(2)
	(3)
	(4)

talked to Greg and he will move 15' from prop line

Westernland across road is all wetland

CONFORMING SEPTIC SYSTEM: _____ YES _____ NO If no, list reasons below.
 COMMENTS OR PROBLEMS (drainage, swales, wetlands, need gutters, etc.) _____


APPROVED: YES OR NO

INSPECTORS NAME Bub Gault DATE 5/9/16 # PICTURES _____

SOIL BORING LOGS AND SKETCH PLAN ON REVERSE SIDE

AITKIN COUNTY BUILDING PERMIT SITE PLAN

Please indicate the location of: Wells, well setback to system components, buildings, septic system components, reserved septic system area, property lines, waterways, and buried lines. Include size, length, and appropriate distances from fixed reference points. Provide a North directional arrow!

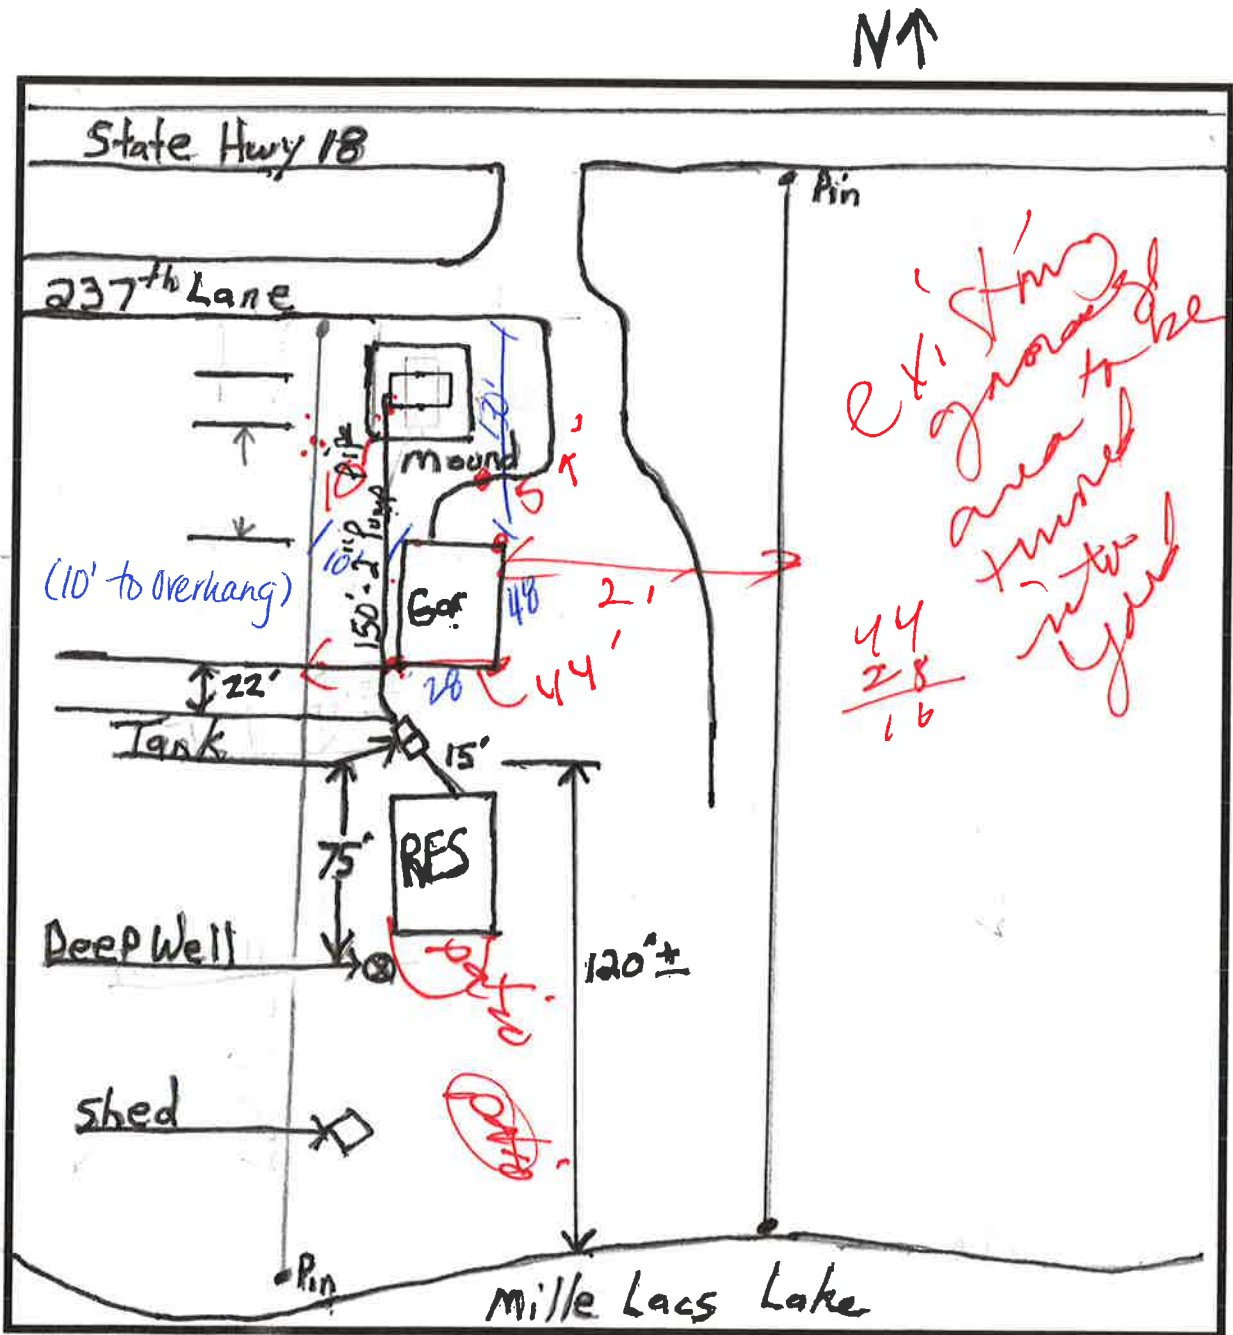


28x48=1344

CLIENT: Mike Haeg

SKETCH SHEET

DATE: 4/18/16

MAP DRAWN TO SCALE 1/4" = 10' WITH A NORTH ARROW

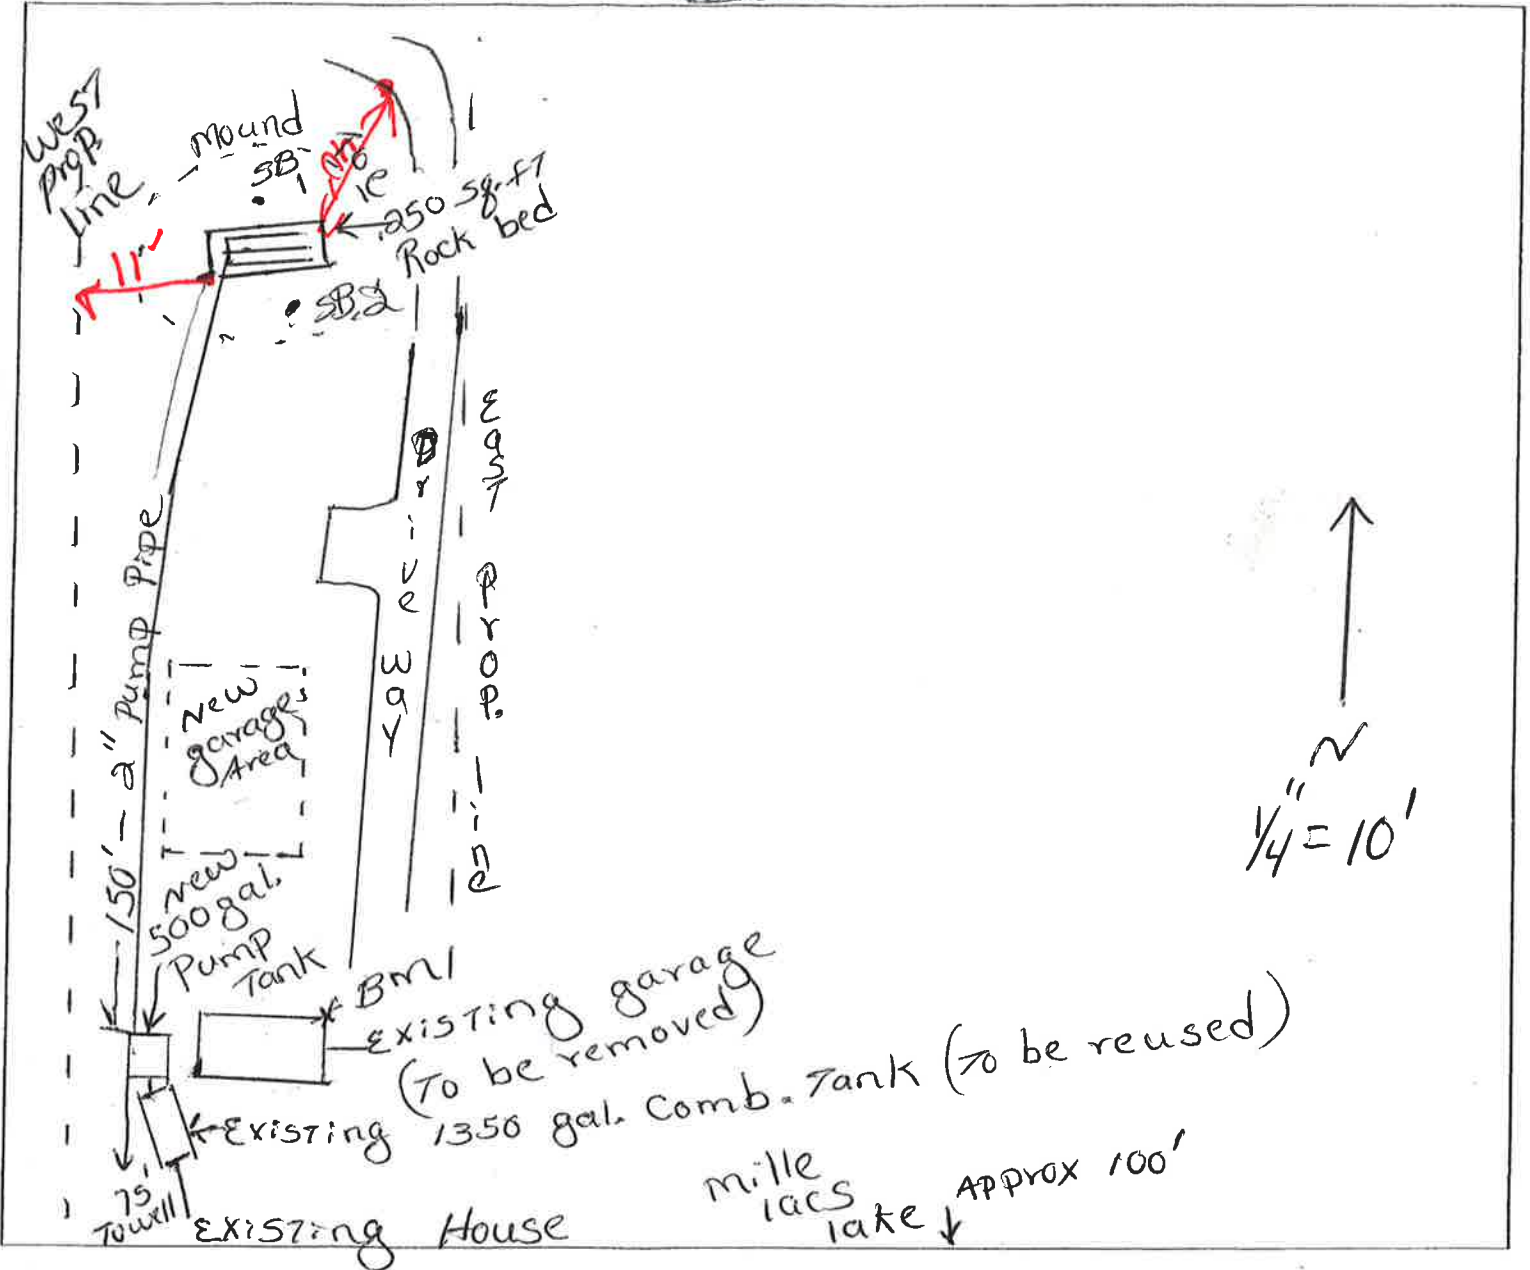

CHECK OFF LIST--HAVE ALL OF THE FOLLOWING BEEN DRAWN ON THE MAP??

SHOW EXISTING OR PROPOSED

- WATER WELLS WITHIN 100 FT OF TREATMENT AREAS
- PRESSURE WATER LINES WITHIN 10 FT OF TREATMENT AREAS
- STRUCTURES
- ALL SOIL TREATMENT AREAS
- HORIZONTAL AND VERTICAL REFERENCE
- POINT OF SOIL BORINGS
- LOT EASEMENTS
- DISTURBED/COMPACTED AREAS
- SITE PROTECTION--LATHES AND RIBBON EVERY 15 FT
- ACCESS ROUTE FOR TANK MAINTENANCE
- LOT IMPROVEMENTS
- ALL ISTS COMPONENTS
- DIRECTION OF SLOPE
- ALL LOT DIMENSIONS

REQUIRED SETBACKS

- STRUCTURES
- OHWL
- PROPERTY LINES

COMMENTS:

INDICATE ELEVATIONS

- BENCHMARK 100
- ELEVATION OF SEWER LINE @ HOUSE/VA 98
- ELEVATION @ TANK INLET 98
- ELEVATION @ BOTTOM OF ROCK LAYER 102
- ELEVATION @ BOTTOM OF BORING OR RESTRICTIVE LAYER 99
- ELEVATION OF PUMP 94
- ELEVATION OF DISTRIBUTION DEVICE 103

DESIGNER SIGNATURE Greg Westerlund

LICENSE# 663

DATE 4/18/16