


Proposed drawing

5B2#
 0 to 2" topsoil
 2" to 14" 10%R 5/4
 14" Motling Gley chert 2
 4/10 B


5B2#
 0" to 26" fill sub 10%R 5/4
 26" Motling
 chert 2 for Gley
 4/10 B

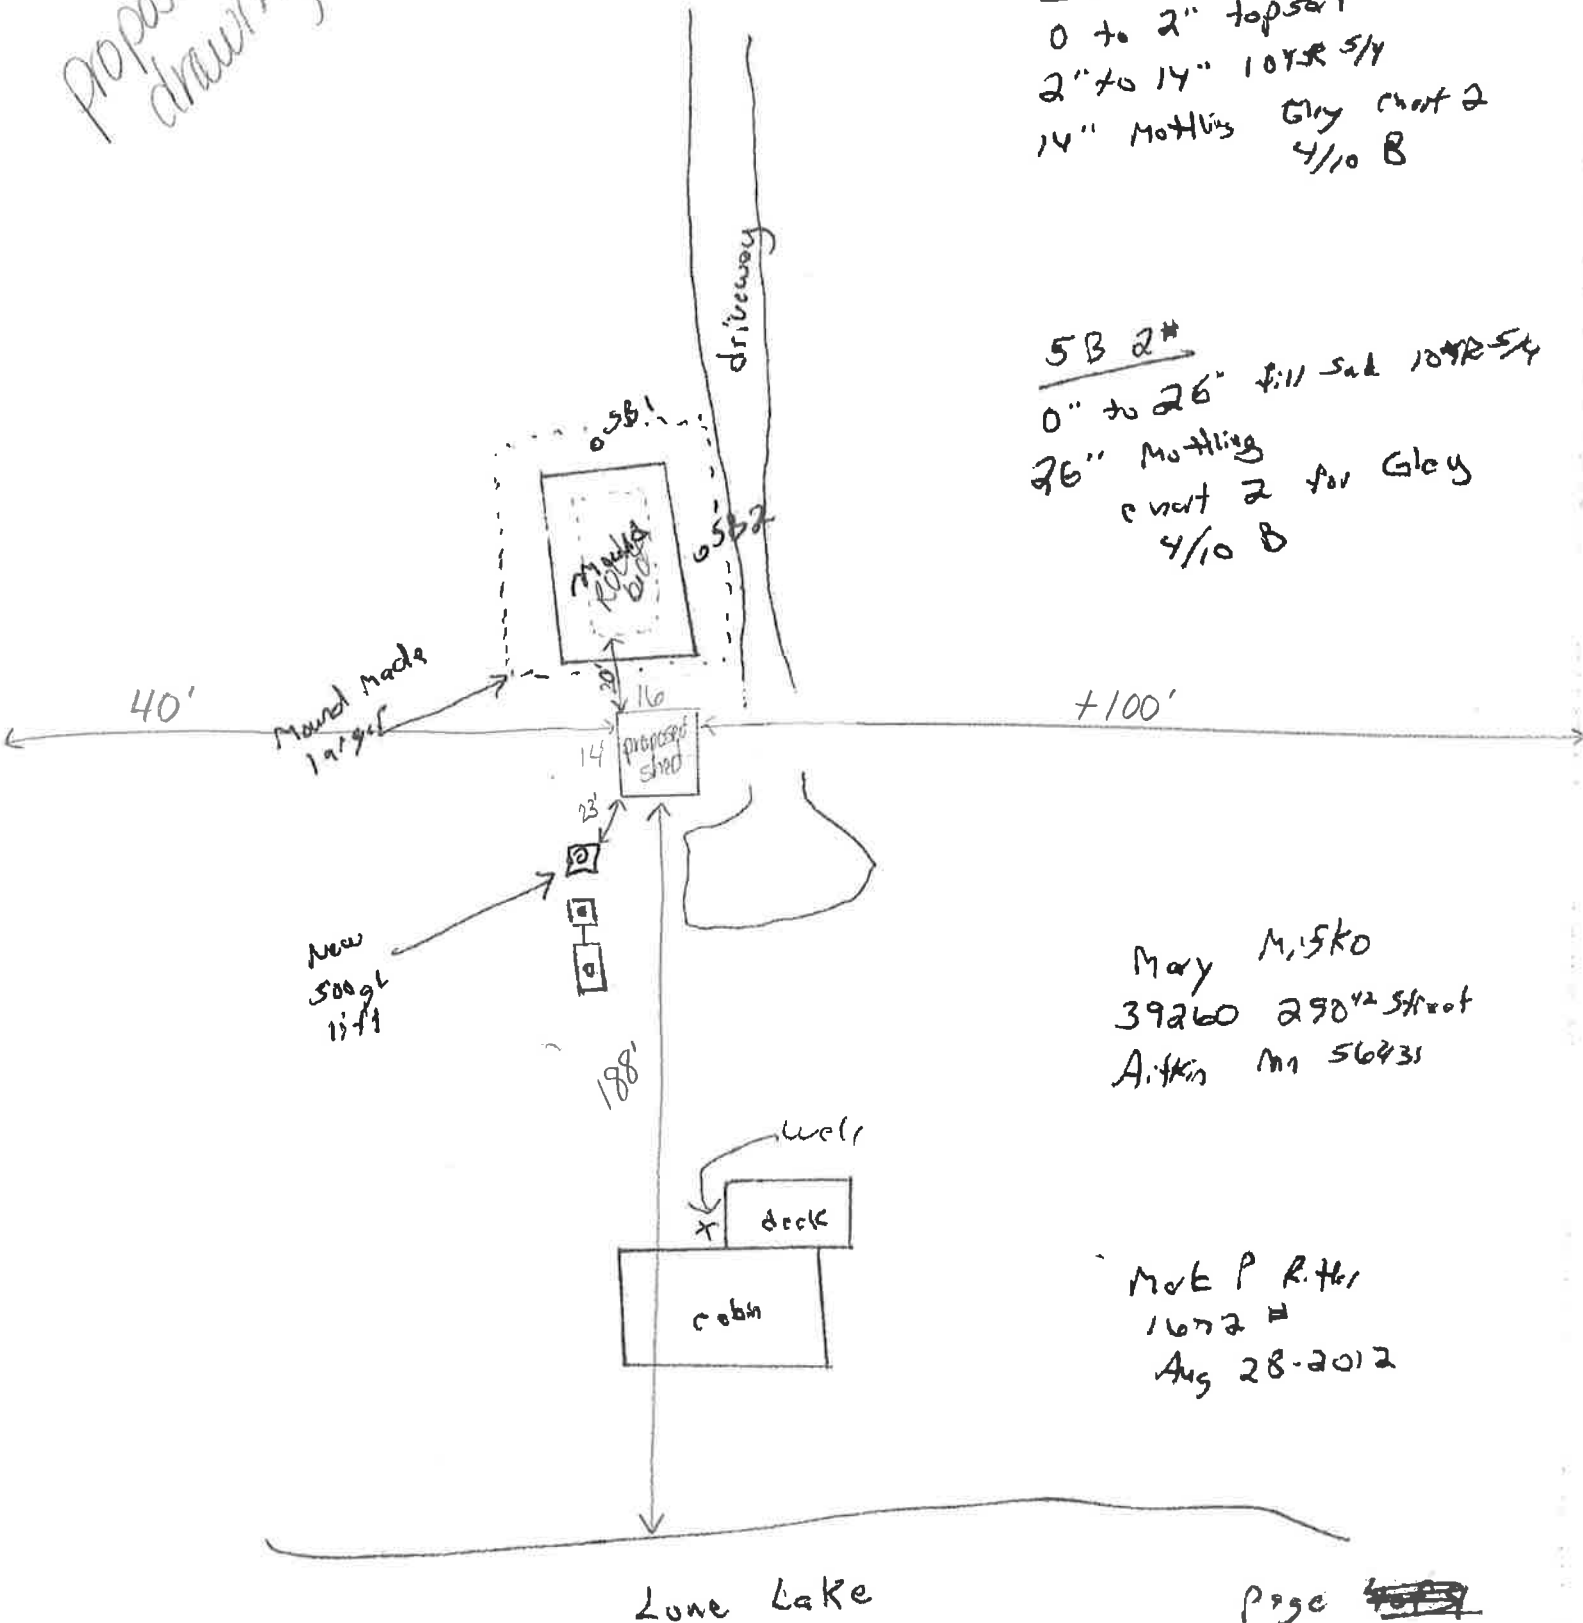

May Misko
 39260 290^{1/2} Street
 Aitkin Mn 56431

Mark P. R. Her
 1672 #
 Aug 28-2012

Existing

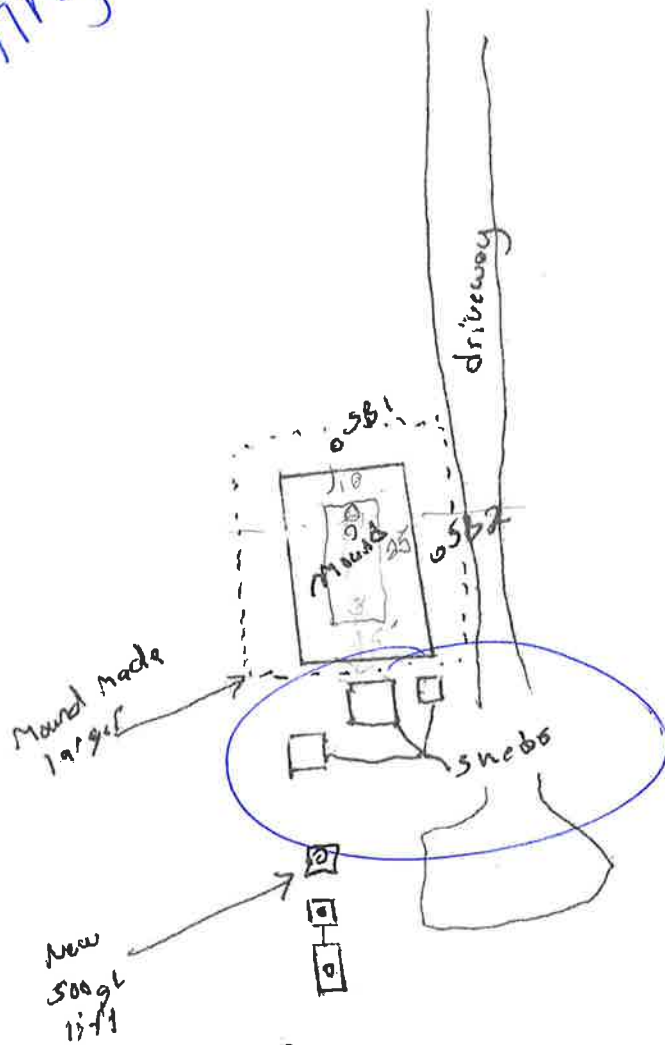


5B2#
 0 to 2" topsoil
 2" to 14" 10%R 5/4
 4/10 B

5B2#
 0" to 26" fill sub 10%R 5/4
 4/10 B

These 3 sheds
 will be demol'd.

May Misko
 39260 290^{1/2} Street
 Aitkin Mn 56431

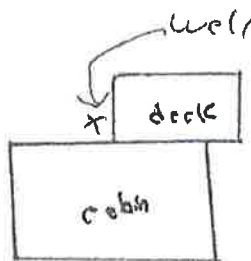

Mark P. R. Her
 1672 #
 Aug 28-2012