


CLIENT: Dale Volin

DATE: 11/04

MAP DRAWN TO SCALE WITH A NORTH ARROW

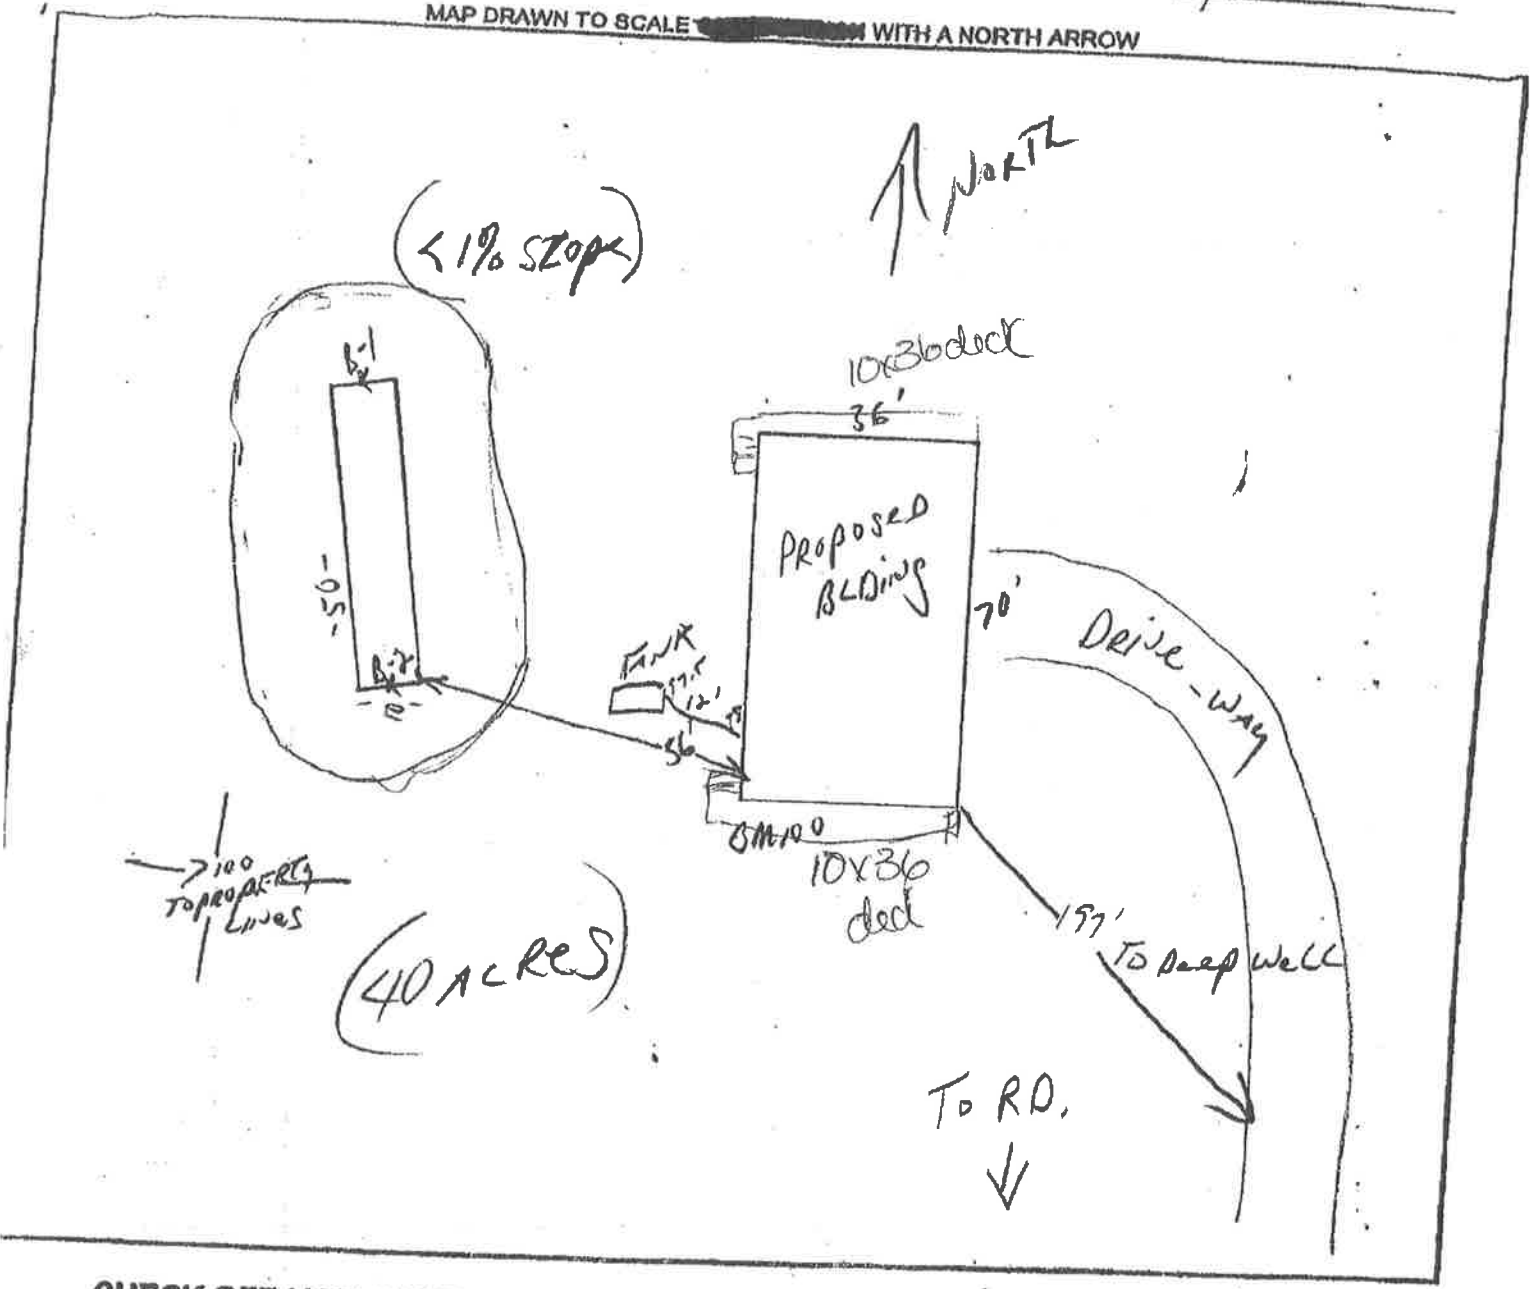

CHECK OFF LIST-HAVE ALL OF THE FOLLOWING BEEN DRAWN ON THE MAP??

- SHOW EXISTING OR PROPOSED WATER WELLS WITHIN 100 FT OF TREATMENT AREAS
- PRESSURE WATER LINES WITHIN 10 FT OF TREATMENT AREAS
- STRUCTURES
- ALL SOIL TREATMENT AREAS
- HORIZONTAL AND VERTICAL REFERENCE POINT OF SOIL BORINGS
- LOT EASEMENTS
- DISTURBED/COMPACTED AREAS
- SITE PROTECTION-LATHE AND RIBBON EVERY 15 FT
- ACCESS ROUTE FOR TANK MAINTENANCE
- WIRED SETBACKS
- STRUCTURES
- HWL
- COMMENTS:

- LOT IMPROVEMENTS
- ALL ISTS COMPONENTS
- DIRECTION OF SLOPE
- ALL LOT DIMENSIONS
- PROPERTY LINES

INDICATE ELEVATIONS

- 100
- 98
- 97.5
- 102
- 99
- 96
- 102.8

- BENCHMARK *Build site*
- ELEVATION OF SEWER LINE @ HOUSE
- ELEVATION @ TANK INLET
- ELEVATION @ BOTTOM OF ROCK LAYER
- ELEVATION @ BOTTOM OF BORING OR RESTRICTIVE LAYER
- ELEVATION OF PUMP
- ELEVATION OF DISTRIBUTION DEVICE

SIGNER SIGNATURE *[Signature]*
LICENSE# 2006

DATE 11/04