


**Install an 1860 Combination Tank
for a Temporary Outhouse
(will eventually be used for future Septic System)**

**DAVID SANNES
Parcel# 19-0-046901
SEPTIC DESIGN
4/20/2009**

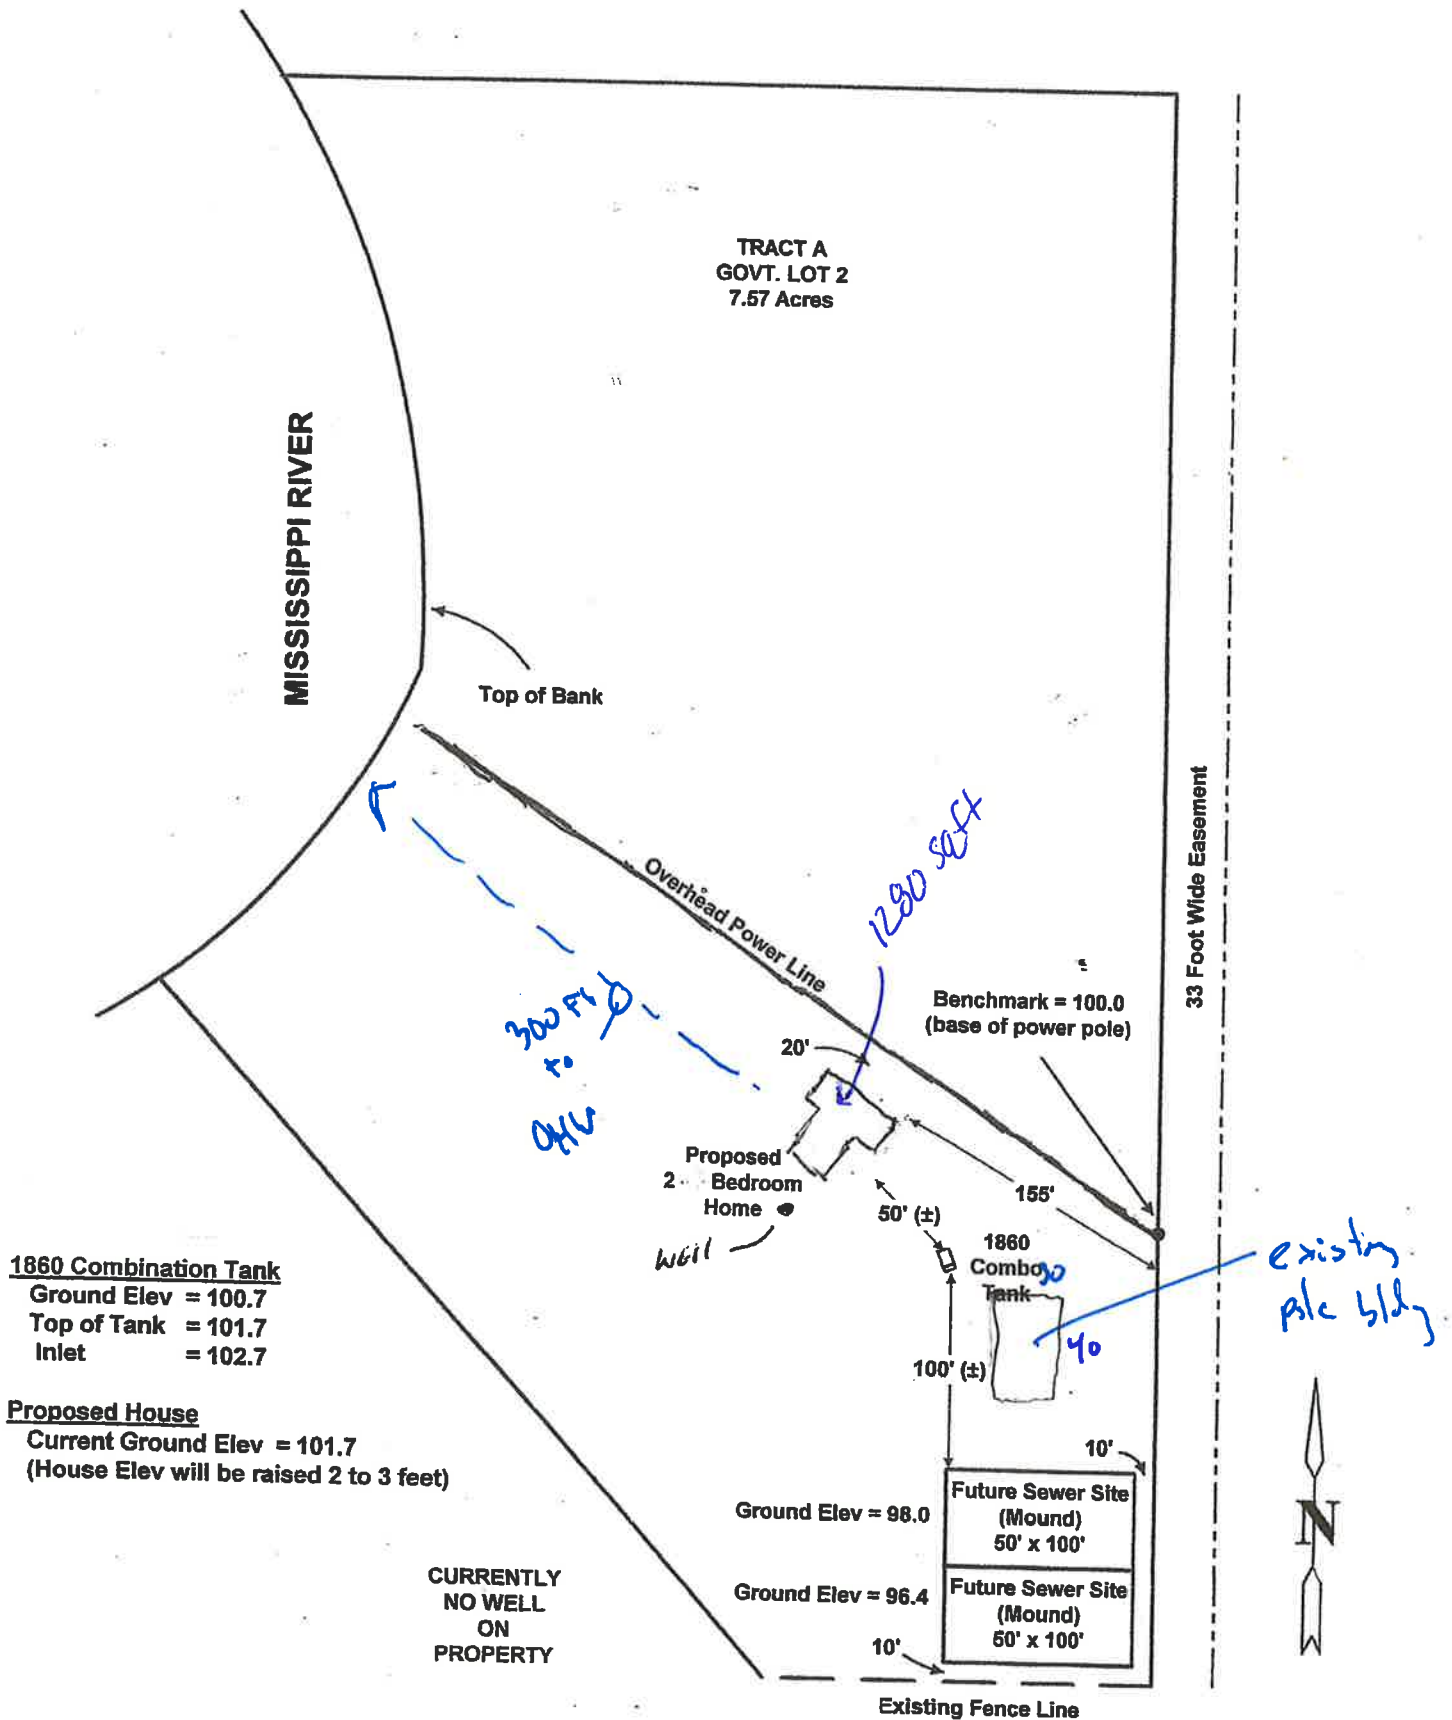

Scale: 1" = 100'