

FIELD EVALUATION SHEET

NAME Michael Schoenecker PERMIT # 2016-000200
PARCEL # 24-0-004404 TWP 46-26 SECTION 03

CHECK THE FOLLOWING PRIOR TO INSPECTION

B. Hargrave NAME OF SITE EVALUATOR
NAME OF DESIGNER
NAME OF INSTALLER
____ LOT OF RECORD BEFORE 1-21-92 (SL) IR 1-10-95 (NSL), IF NO, ALT. SITE? ____
____ SITE PLAN WITH SETBACK DISTANCES AND DIMENSIONS
____ ARE ISTS SITES PROTECTED FROM DAMAGE? IF NOT, WHEN ____
____ DESIGN ____ PERC TESTS ____ SOIL BORINGS, 2 PER SITE
____ NUMBER OF BEDROOMS (INCLUDE POTENTIAL)
____ CROSS SECTION SHEET ____ TRENCH DESIGN SHEET
____ MOUND DESIGN SHEET ____ OTHER OR PERFORM.
____ PRESSURE DISTRIBUTION SHEET ____ PUMP CALC. TEST
____ WATER USE CALCULATIONS ____
____ GARBAGE DISPOSAL ____ HOT TUB
____ EASEMENTS ON LOT, IS ROAD PUBLIC OR PRIVATE SEE DEED/PLAT
____ NATURAL LANDSCAPE PROTECTION PLAN

STAKING: BUILDINGS ____, DRAINFIELD ____, BORINGS ____, WELL ____
BUILDING SETBACKS: ROAD ____, SIDE ____, REAR ____, BLUFF ____,
LAKE/RIVER ____

COMPLETE DURING SITE EVALUATION
 BUILDINGS STAKED ____ DRAINFIELD STAKED ____ BORINGS STAKED
____ WELL STAKED

SETBACKS (MEASURE DISTANCE)

	DRAINFIELD	HOUSE
FLOOD PLAIN	YES/NO	YES/NO
WETLANDS	YES/NO	YES/NO
LAKE, RIVER, PROTECTED WATERS	____	____
ROAD RIGHT OF WAY	____	____
BLUFF	____	____
SIDE LOT LINE	____	____
REAR LOT LINE	____	____
HOUSE OR OTHER STRUCTURE	____	____
WELL	____	____
EASEMENTS	____	____
NEIGHBORING WELL (S) TO ISTS	(1) ____ (2) ____	(3) ____ (4) ____
DRAINFIELD AREA DISTURBED	____	____

see site plan

CONFORMING SEPTIC SYSTEM: YES ____ NO If no, list reasons below.
COMMENTS OR PROBLEMS (drainage, swales, wetlands, need gutters, etc.)


APPROVED: YES OR NO

INSPECTORS NAME Dryan Hargrave DATE 5/24/2016 # PICTURES 8

SOIL BORING LOGS AND SKETCH PLAN ON REVERSE SIDE

TRACT "C"

150' FROM LAKE
OR

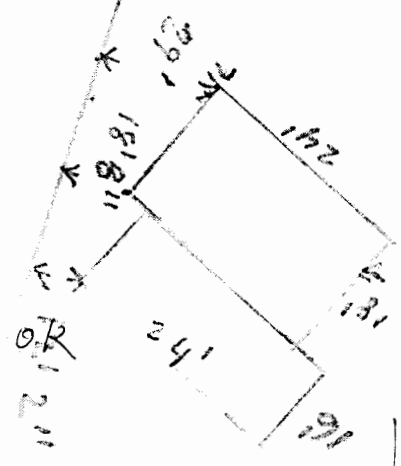

DW

TRACT "D"

366TH PLACE