


Drawing is
approximate!

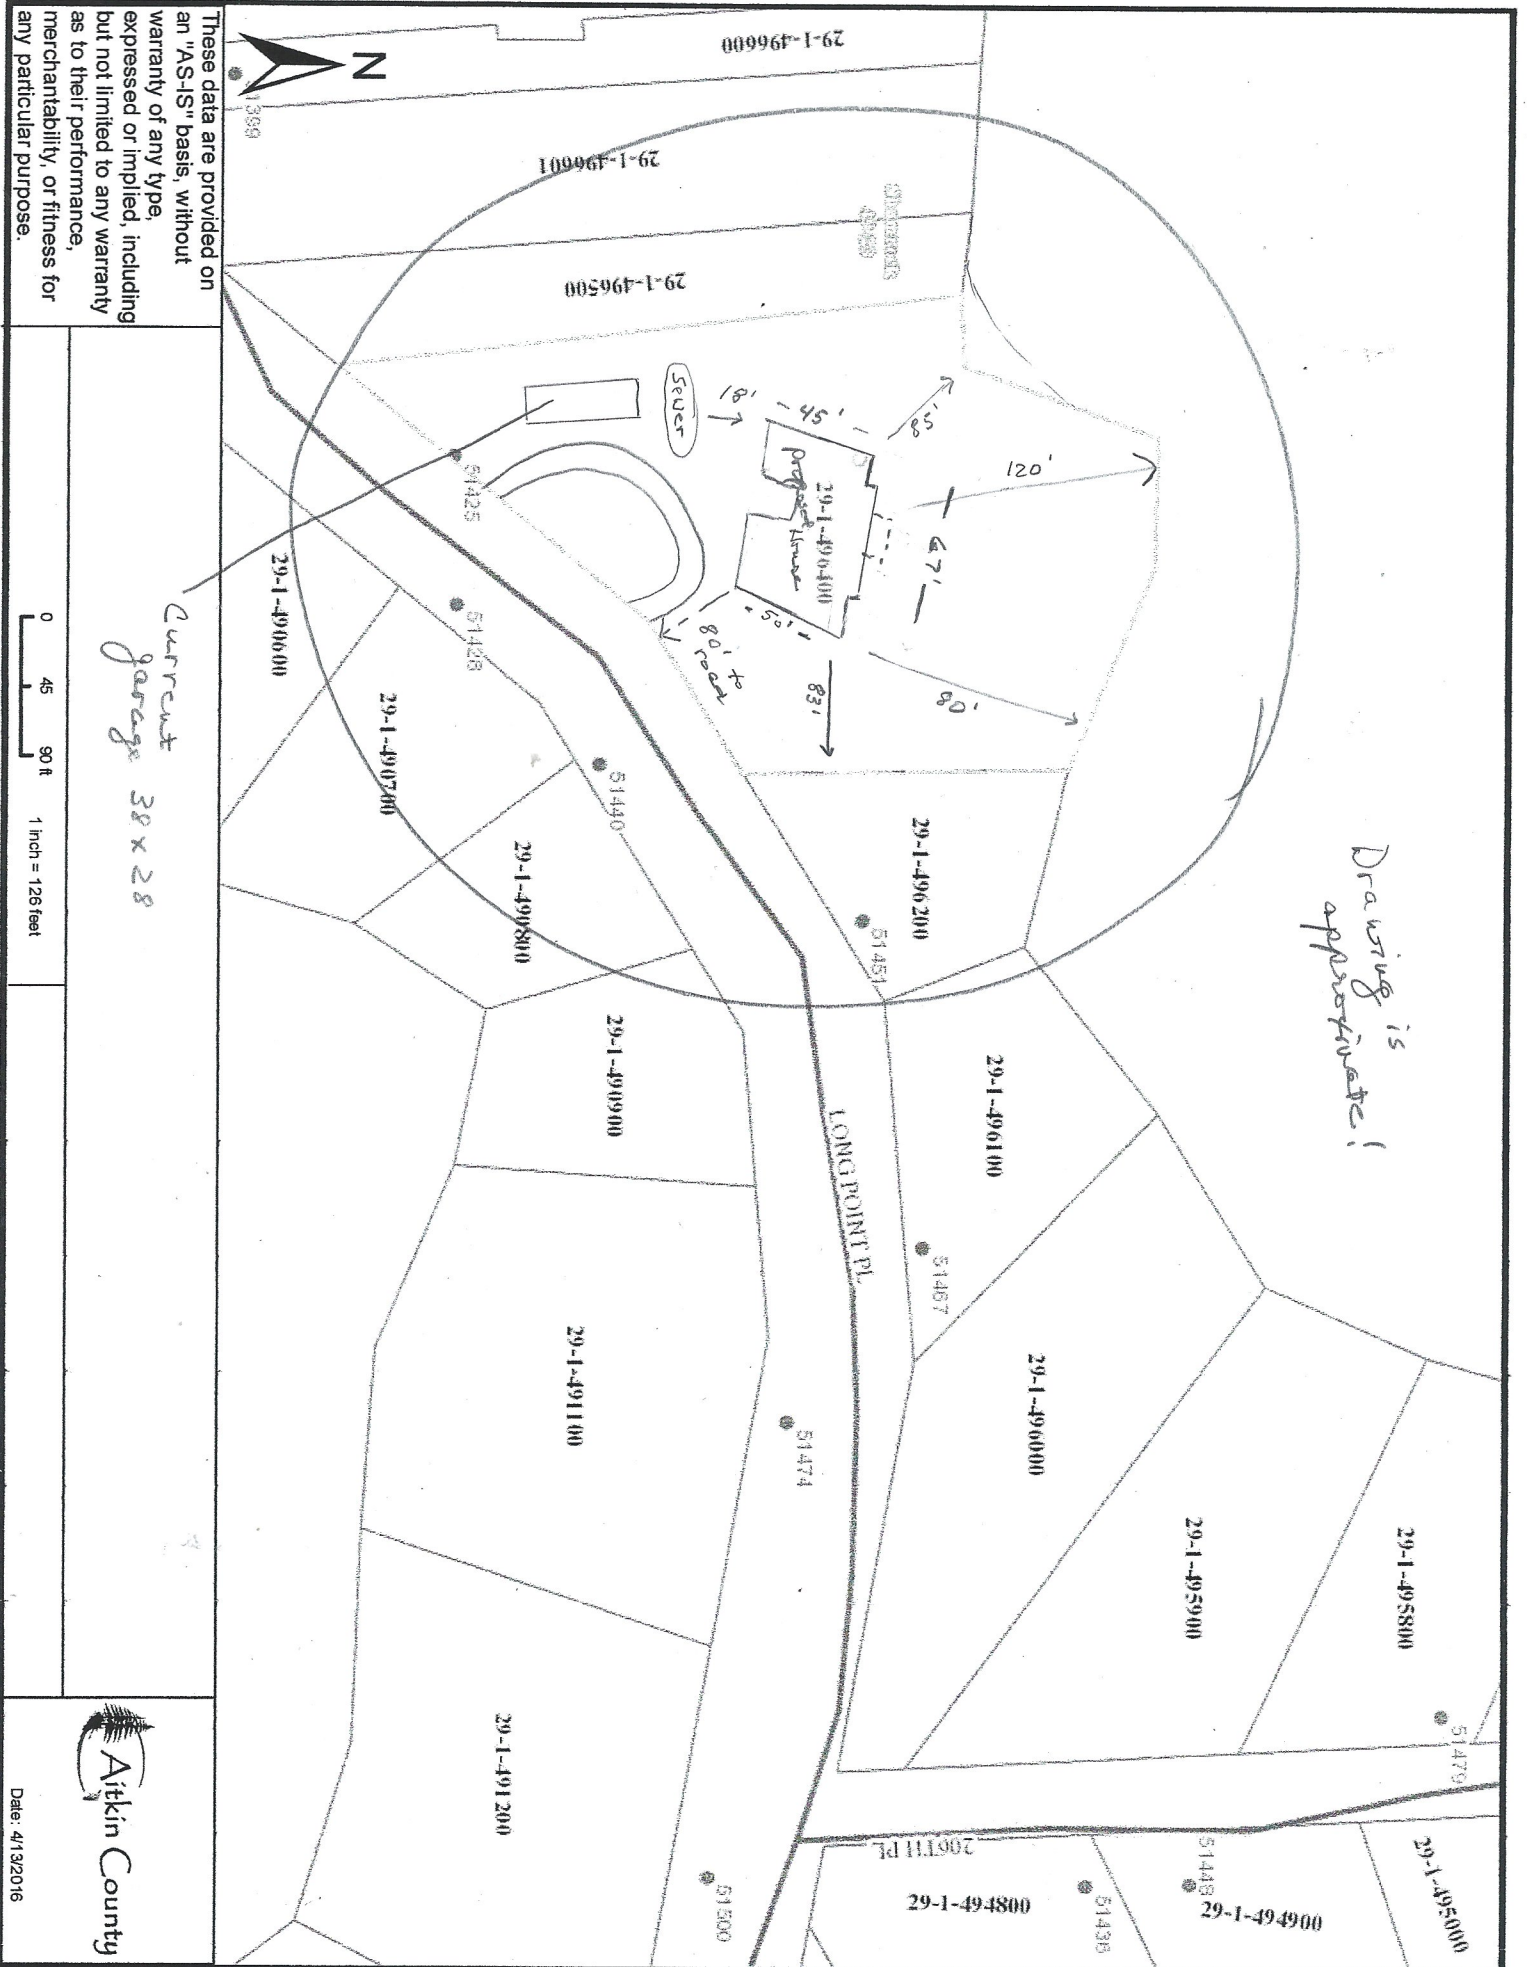

These data are provided on an "AS-IS" basis, without warranty of any type, expressed or implied, including but not limited to any warranty as to their performance, merchantability, or fitness for any particular purpose.

Current
garage 38 x 28



Date: 4/13/2016