

FIELD EVALUATION SHEET

NAME Russell Varitz PERMIT # 2016-000218
 PARCEL # 24-0-021502 TWP 46-26 SECTION 11

CHECK THE FOLLOWING PRIOR TO INSPECTION

B. Hagan NAME OF SITE EVALUATOR
 _____ NAME OF DESIGNER
 _____ NAME OF INSTALLER

LOT OF RECORD BEFORE 1-21-92 (SL) IR 1-10-95 (NSL), IF NO, ALT. SITE? _____
 _____ SITE PLAN WITH SETBACK DISTANCES AND DIMENSIONS
 _____ ARE ISTS SITES PROTECTED FROM DAMAGE? IF NOT, WHEN _____
 _____ DESIGN _____ PERC TESTS _____ SOIL BORINGS, 2 PER SITE
 _____ NUMBER OF BEDROOMS (INCLUDE POTENTIAL)
 _____ CROSS SECTION SHEET _____ TRENCH DESIGN SHEET
 _____ MOUND DESIGN SHEET _____ OTHER OR PERFORM.
 _____ PRESSURE DISTRIBUTION SHEET _____ PUMP CALC. TEST
 _____ WATER USE CALCULATIONS _____
 _____ GARBAGE DISPOSAL _____ HOT TUB
 _____ EASEMENTS ON LOT, IS ROAD PUBLIC OR PRIVATE SEE DEED/PLAT
 _____ NATURAL LANDSCAPE PROTECTION PLAN

STAKING: BUILDINGS _____, DRAINFIELD _____, BORINGS _____, WELL _____
 BUILDING SETBACKS: ROAD _____, SIDE _____, REAR _____, BLUFF _____,
 LAKE/RIVER _____

COMPLETE DURING SITE EVALUATION
 BUILDINGS STAKED _____ DRAINFIELD STAKED _____ BORINGS STAKED _____
 _____ WELL STAKED _____

SETBACKS (MEASURE DISTANCE)

	<u>DRAINFIELD</u>	<u>HOUSE</u>
	YES/NO	YES/NO
FLOOD PLAIN	_____	YES <input checked="" type="checkbox"/> NO <input checked="" type="checkbox"/>
WETLANDS	YES/NO	YES <input checked="" type="checkbox"/> NO <input checked="" type="checkbox"/>
LAKE, RIVER, PROTECTED WATERS	_____	_____
ROAD RIGHT OF WAY	_____	_____
BLUFF	_____	_____
SIDE LOT LINE	_____	16'
REAR LOT LINE	_____	_____
HOUSE OR OTHER STRUCTURE	_____	_____
WELL	_____	_____
EASEMENTS	_____	_____
NEIGHBORING WELL (S) TO ISTS	(1) _____ (2) _____	(3) _____ (4) _____
DRAINFIELD AREA DISTURBED	_____	_____

See site Plan


CONFORMING SEPTIC SYSTEM: YES _____ NO If no, list reasons below.
 COMMENTS OR PROBLEMS (drainage, swales, wetlands, need gutters, etc.) _____

APPROVED: YES OR NO

INSPECTORS NAME B. Hagan DATE 5/25/2018 # PICTURES 6


SOIL BORING LOGS AND SKETCH PLAN ON REVERSE SIDE

These data are provided on an "AS-IS" basis, without warranty of any type, expressed or implied, including but not limited to any warranty as to their performance, merchantability, or fitness for any particular purpose.

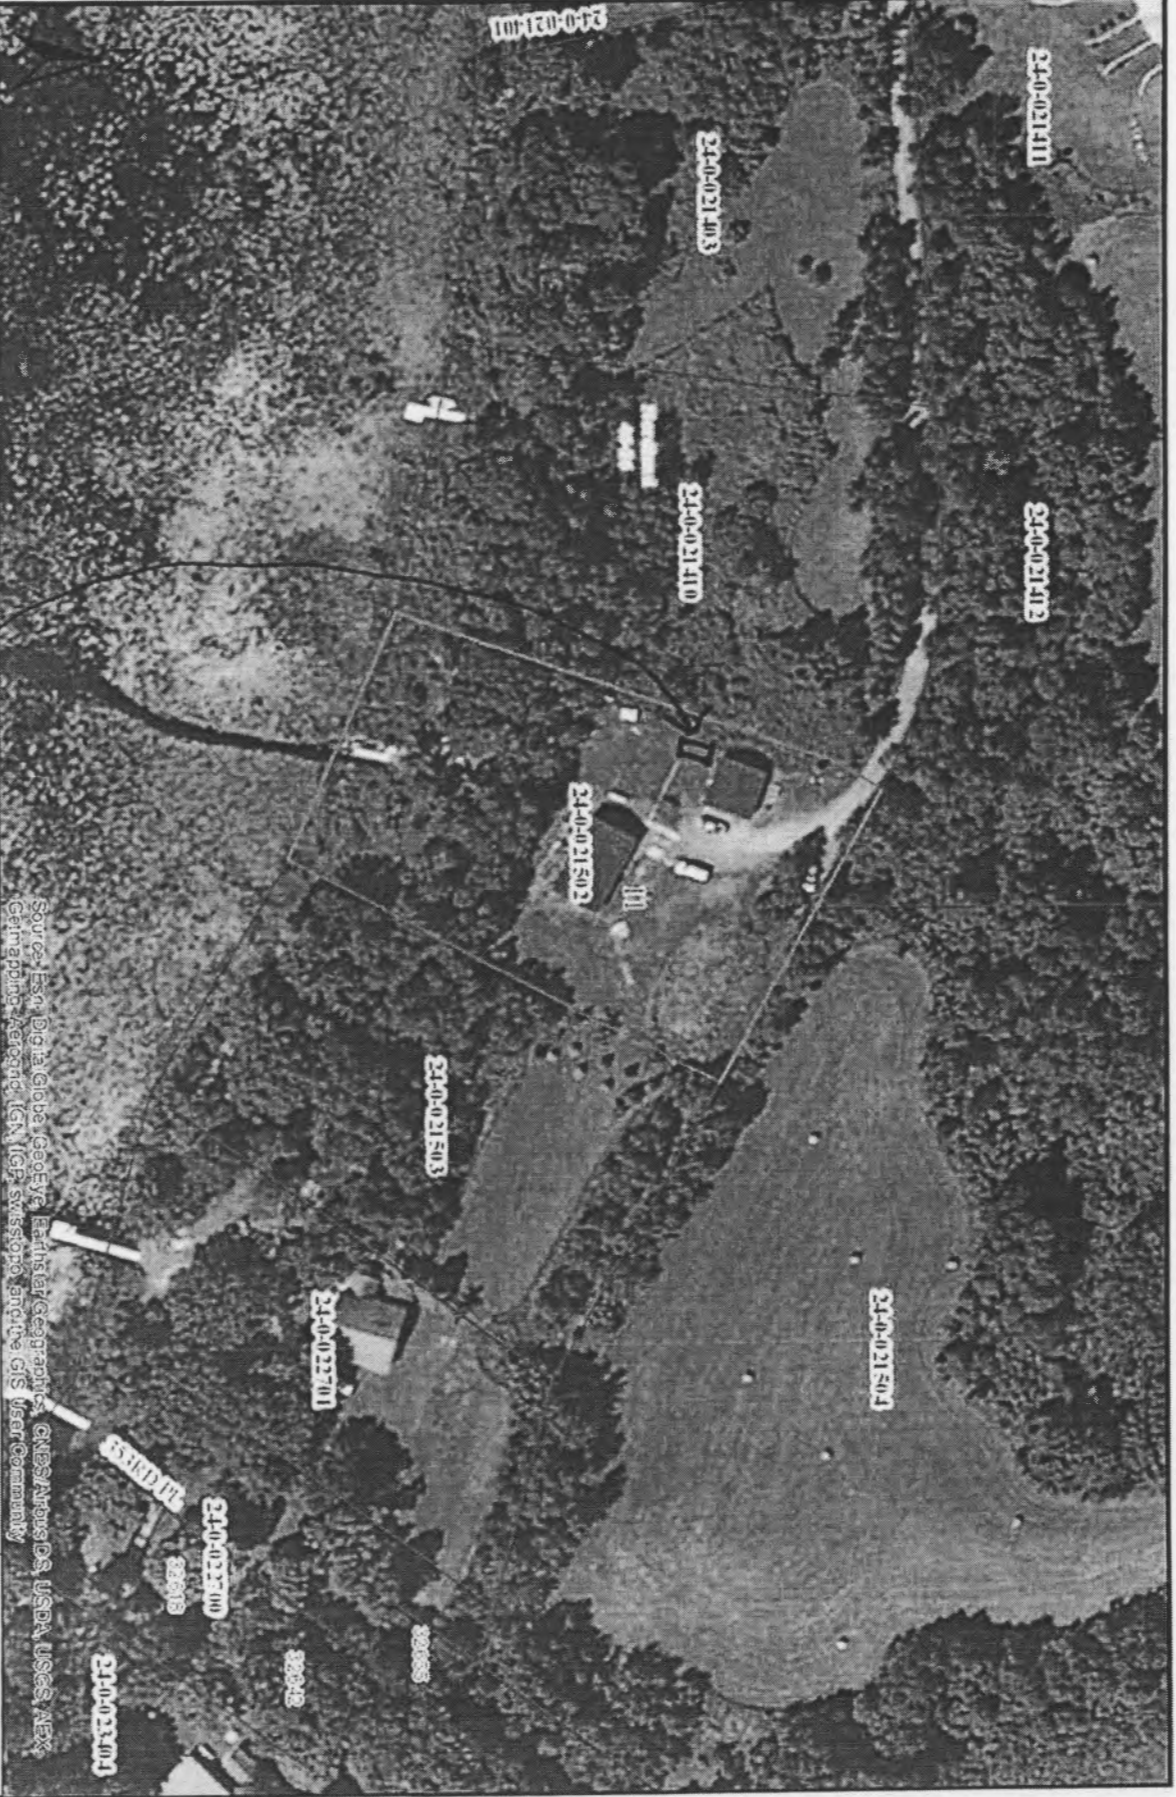


10 x 18
SHED

* Will be split off road

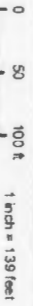

Source: Esri, DigitalGlobe, GeoEye, Earthstar Geographics, CNES/Airbus DS, USDA, USGS, AeroX, GeoEye, IGN, AerGRID, IGN, IGP, Swisstopo, and the GIS User Community

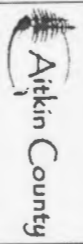

Date: 5/10/2016