

# AITKIN COUNTY ZONING

PERMIT NUMBER **41913**

PARCEL NUMBER 29-0-040008

Location PT GOVT LOT 5 E OF HWY 65 19 49 23  
Lot Block Gov't Lot Section Twp. Rge

AS IN DOC 364569 LESS PT IN DOC 375166

Issued May 11, 2016 To US Development & Leasing Corp

Nature of Authorization 200' x 200' commercial building addition  
(comm. bldg. addn > 2501 sq. ft.)

New Construction  Alteration  **NOT FOR HUMAN HABITATION**

Sewer Installation

Flood Plain and Lowest Floor Elev. \_\_\_\_\_

**NOTE:**


This permit must be posted in a conspicuous place on premises on which work is to be done and remain until work has been completed and inspected.

This permit expires one year from date of issuance  
**NOT TRANSFERABLE**

Kalea S.  
ZONING ADMINISTRATOR

**No Portion of any Sewage Disposal System shall be Covered Prior to Inspection.**

6-29-16 additional 325' x 100' building expansion added to permit. OK per TN

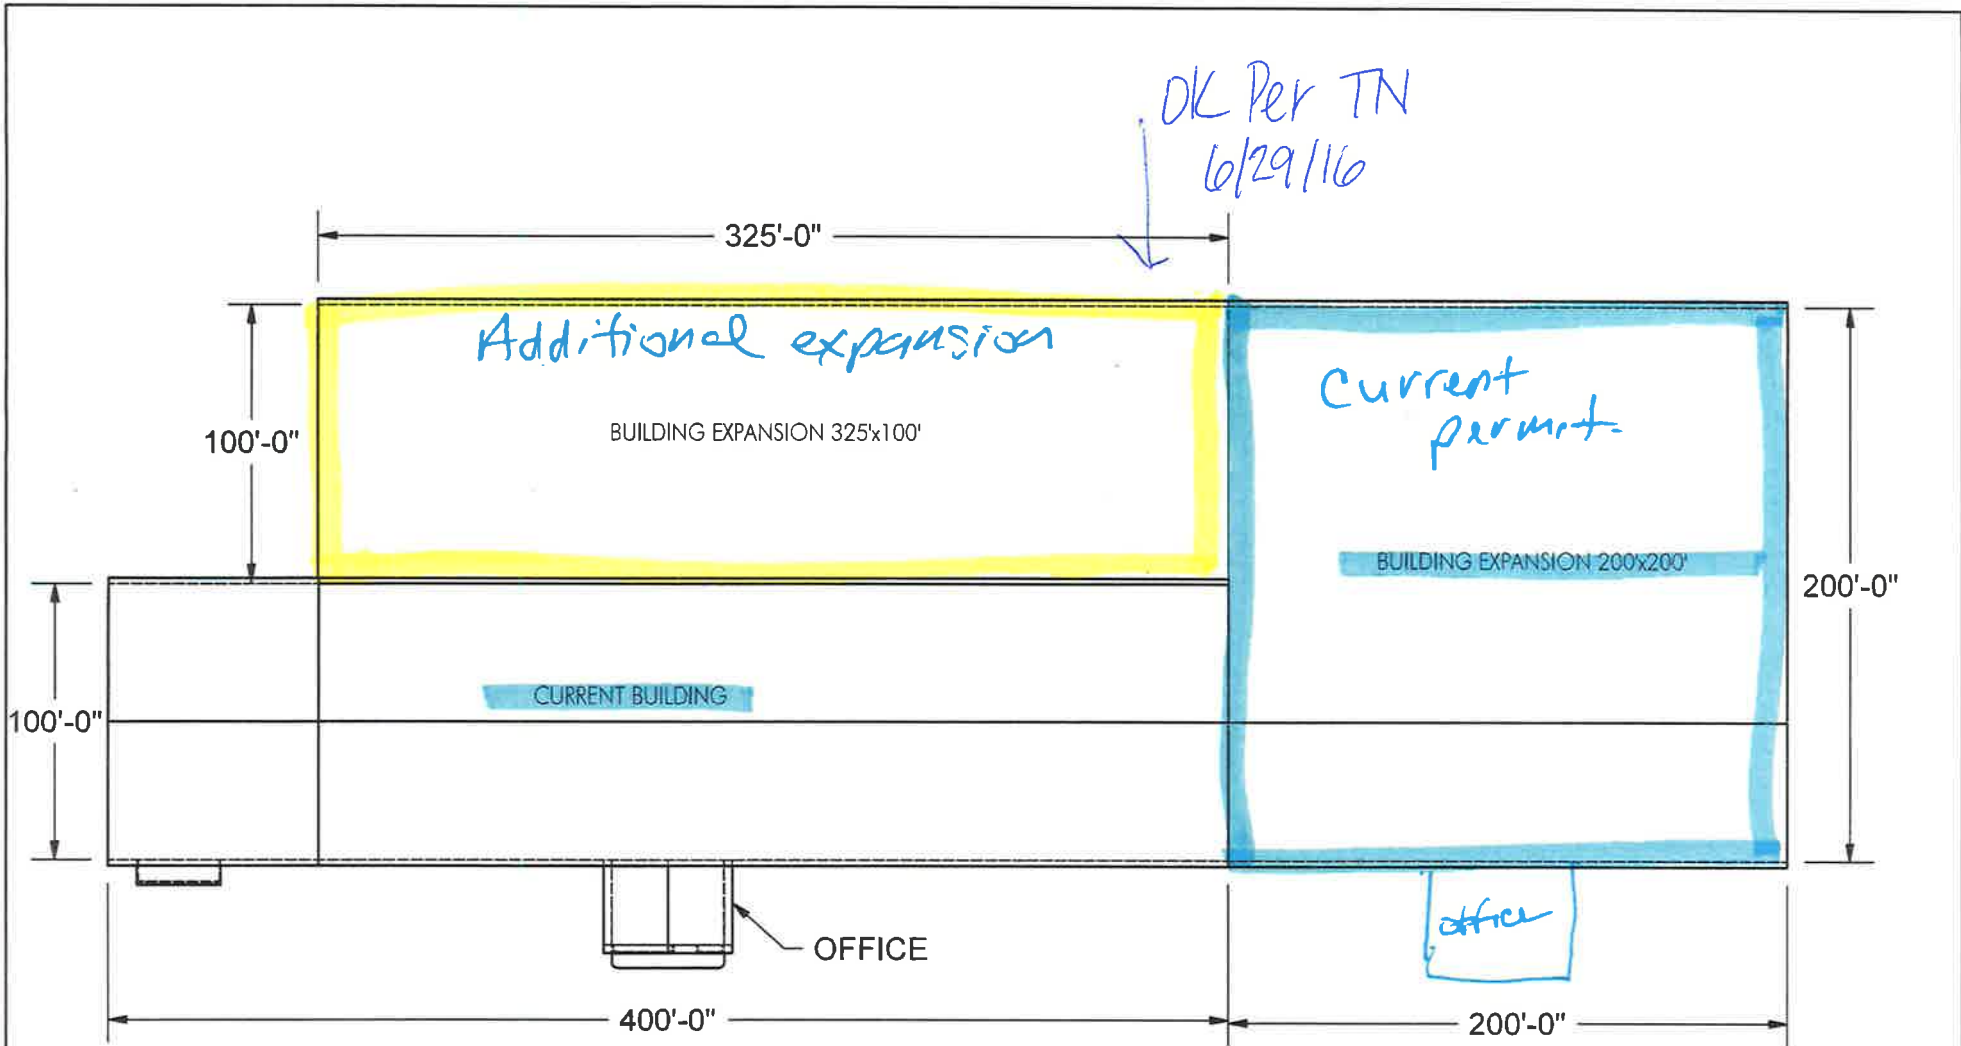

**FLOE International, Inc.**

48473 State Hwy 65, McGregor, MN 55760 (218) 426-3563

TITLE:

DATE: 6/23/2016 DRAWN BY: jeremyj MATERIAL:

THIS DRAWING AND THE SUBJECT MATTER THEREOF IS FLOE INT'L INC. PROPERTY AND IS CONFIDENTIAL INFORMATION. DISCLOSURE OR USE OF SUCH INFORMATION WITHOUT THE WRITTEN CONSENT OF FLOE INT'L INC. IS PROHIBITED. EXCEPT AS PROVIDED BY SEPERATE WRITTEN AGREEMENT, THE COMPANY MAKES NO WARRANTY EXPRESS, IMPLIED OR STATUTORY AS TO THIS DRAWING.

TOLERANCES UNLESS OTHERWISE SPECIFIED:  
 FRACTIONAL: +/- 1/16"  
 0.00 DEC.: +/- 0.031  
 0.000 DEC.: +/- 0.015  
 ANGLES: +/- 1/2"

SCALE: SHEET: 1 of 1 PART NO: MCG East Building Assy REV.