


PROPERTY ADDRESS: 31135 327<sup>TH</sup> AVE, AITKIN, MN 56431  
LEGAL DESCRIPTION: S 100 FT OF N 200 FT OF LOT 3IN DOC 226860

16-MAY-2016



255'

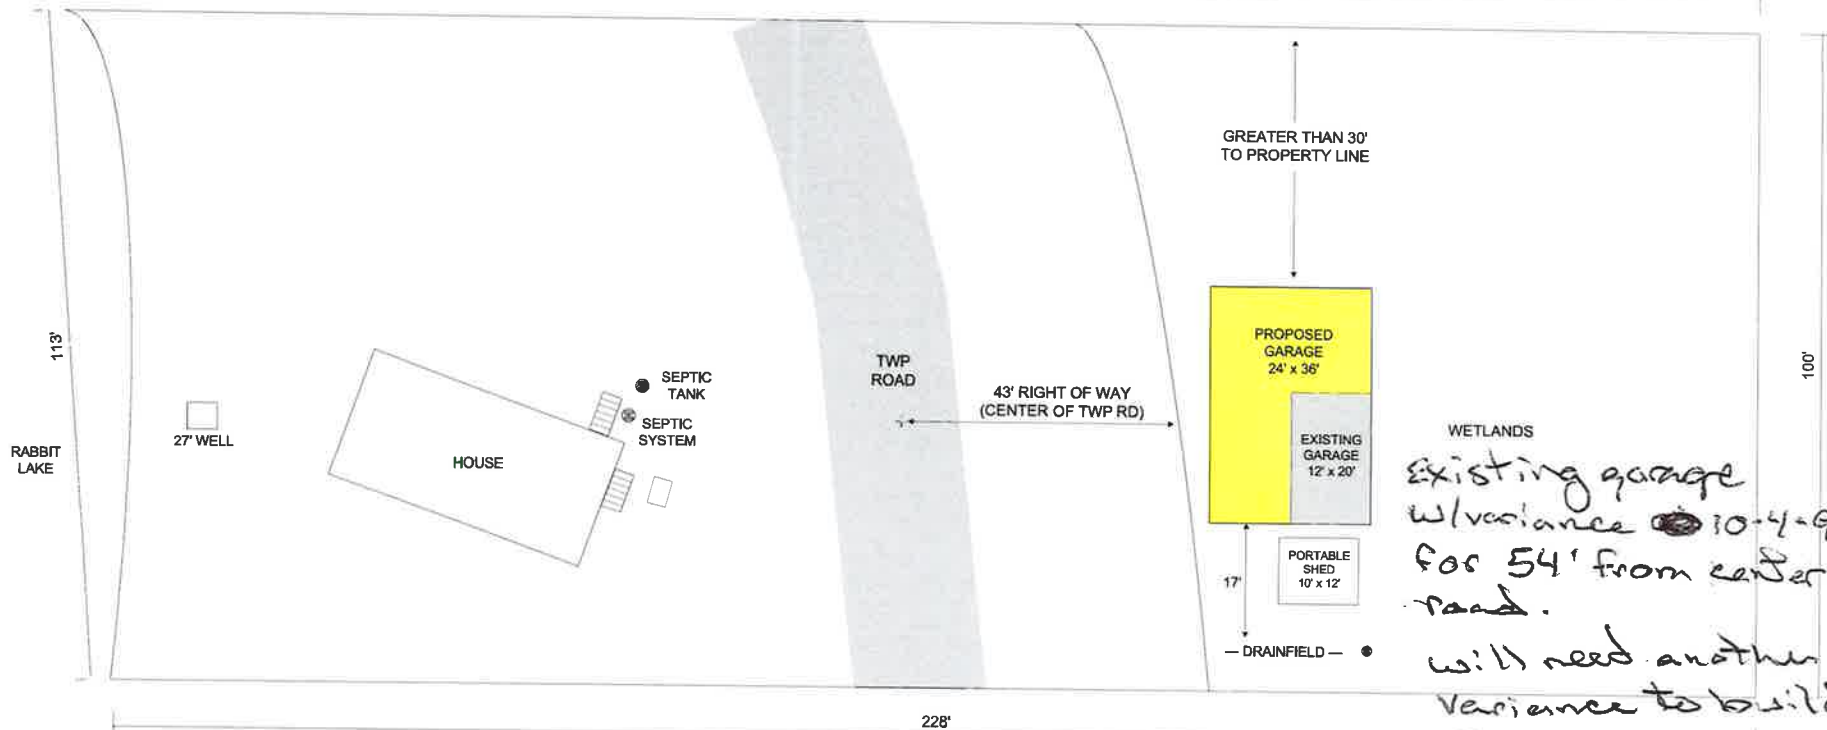

WETLANDS  
*Existing garage w/ variance 10-4-95 for 54' from center of road.  
will need another variance to build closer*