

FIELD EVALUATION SHEET

NAME Laura Dreon PERMIT # 2016-00315
 PARCEL # 35-1-072100 TWP 49-26 SECTION 16

CHECK THE FOLLOWING PRIOR TO INSPECTION

B. Hargrave NAME OF SITE EVALUATOR
 _____ NAME OF DESIGNER
 _____ NAME OF INSTALLER

- LOT OF RECORD BEFORE 1-21-92 (SL) IR 1-10-95 (NSL), IF NO, ALT. SITE? _____
- _____ SITE PLAN WITH SETBACK DISTANCES AND DIMENSIONS
- _____ ARE ISTS SITES PROTECTED FROM DAMAGE? IF NOT, WHEN _____
- _____ DESIGN _____ PERC TESTS _____ SOIL BORINGS, 2 PER SITE
- _____ NUMBER OF BEDROOMS (INCLUDE POTENTIAL)
- _____ CROSS SECTION SHEET _____ TRENCH DESIGN SHEET
- _____ MOUND DESIGN SHEET _____ OTHER OR PERFORM.
- _____ PRESSURE DISTRIBUTION SHEET _____ PUMP CALC. TEST
- _____ WATER USE CALCULATIONS _____
- _____ GARBAGE DISPOSAL _____ HOT TUB
- _____ EASEMENTS ON LOT, IS ROAD PUBLIC OR PRIVATE SEE DEED/PLAT
- _____ NATURAL LANDSCAPE PROTECTION PLAN

STAKING: BUILDINGS _____, DRAINFIELD _____, BORINGS _____, WELL _____
 BUILDING SETBACKS: ROAD _____, SIDE _____, REAR _____, BLUFF _____,
 LAKE/RIVER _____

COMPLETE DURING SITE EVALUATION

BUILDINGS STAKED DRAINFIELD STAKED _____ BORINGS STAKED
 _____ WELL STAKED

SETBACKS (MEASURE DISTANCE)

	<u>DRAINFIELD</u>	<u>HOUSE</u>
FLOOD PLAIN	YES/NO	YES/NO
WETLANDS	YES/NO	YES/NO
LAKE, RIVER, PROTECTED WATERS	_____	_____
ROAD RIGHT OF WAY	_____	_____
BLUFF	_____	_____
SIDE LOT LINE	_____	_____
REAR LOT LINE	_____	_____
HOUSE OR OTHER STRUCTURE	_____	_____
WELL	_____	_____
EASEMENTS	_____	_____
NEIGHBORING WELL (S) TO ISTS	_____ (1) _____ (2)	_____ (3) _____ (4)
DRAINFIELD AREA DISTURBED	_____	_____

see site plan

CONFORMING SEPTIC SYSTEM: YES _____ NO If no, list reasons below.
 COMMENTS OR PROBLEMS (drainage, swales, wetlands, need gutters, etc.) _____

APPROVED: YES OR NO

INSPECTORS NAME Bryan Hargrave DATE 6/4/2016 # PICTURES 8

SOIL BORING LOGS AND SKETCH PLAN ON REVERSE SIDE

Existing Garage

Driveway


septic

Approx 20' OK Property boundary

Existing House

well

Approx 50' OK

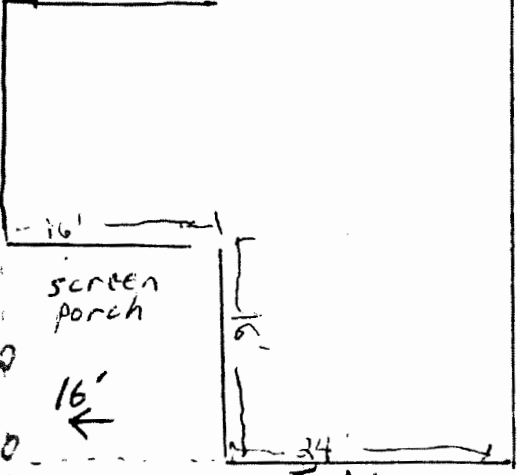

Proposed deck project

screen porch

open deck

108'

108' from water to house OK

8' from house

4' out

4' out

24'

16'

16'

34'

