


29-1-352600

190th
Place
McGaugher
51291

45 X 30 X 10
pole building

475th
- 10 ft from
Tank
Garage 57' - 18' + 39ft -
from Septic Tank
Current Garage

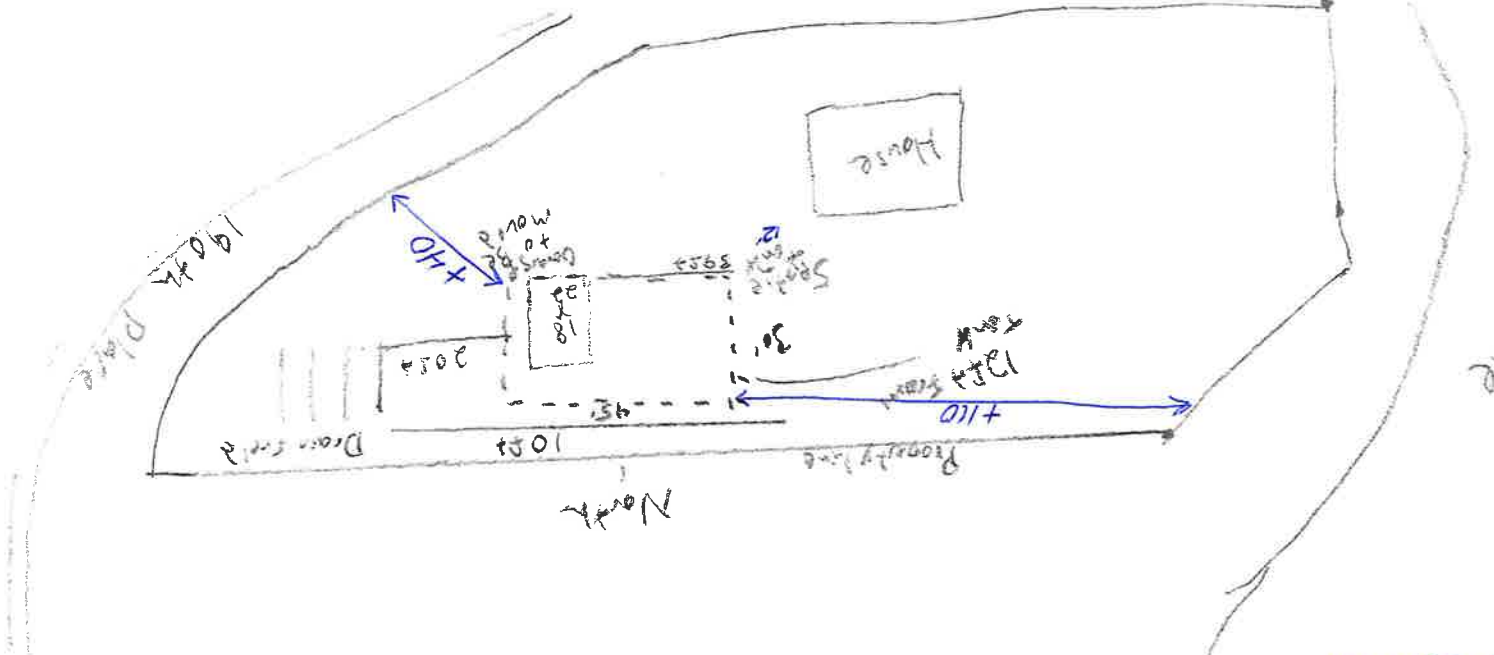

2 lots
29-1-352500
29-1-352600

Rod white marker on north (pin)
property line

2 lots
29-1-352500
29-1-352600