

MAR 30 2016

ZONING PERMIT APPLICATION

FULL NAME Michael Schmid TELE # 952-484-9594
 MAIL ADDRESS 9333 MAGGIE LANE
 CITY SAVAGE STATE MN ZIP 55378
 911 ADDRESS OF PROPERTY 21340 PIKE AVE
 CITY Aitkin STATE MN ZIP 56431
 TOWNSHIP Hazel ton
 LEGAL DESCRIPTION Lot 12 of Mount & McQuillins Millelacs
 SECTION 6 TOWNSHIP 44 RANGE 27 Lake Acres

OFFICE USE ONLY

DATE 4/11/16 APPROVE / DENY [Signature]
 PERMIT# 41825
 PARCEL# 11-1-075300
 RECEIPT# 928736
 CHECK # 2210
 CONFORMING SEPTIC
 YES CI: NO NEW NO
installed NOV 2012 p39305

(circle) RESIDENTIAL COMMERCIAL ACCESSORY NEW BUILDING ALTERATION

BUILDING CONTRACTOR AND LICENSE NUMBER: to be determined

DESCRIBE YOUR PROJECT (IF APPLICABLE, INCLUDE DIMENSIONS OF ALL BUILDINGS COVERED BY THIS APPLICATION)
Looking at 30' x 40' Storage Shed. I had contractor out to walk property, they said they were 99% sure there would be no issues. I would like to get a couple quotes on buildings & site work, but want to make sure county is okay with it before I waste everyones time. I have
 COMMENTS: staked & lot lines marked. driveway will have to be moved a few feet, notice one stake in middle of drive. We purchased property in November of 2015, new construction, let me know what else you would like.

DESIGNER: _____

DATA FOR SEWER CONSTRUCTION: INSTALLER _____ #BEDROOMS/GPD _____

The undersigned hereby makes application for permit to construct as herein specified, agreeing to do all such work in strict accordance with the Ordinances of the County of Aitkin, Minnesota; Minnesota Individual Sewage Disposal Code Minimum Standards set forth by Minnesota Department of Health; and Shoreland Management Standards set forth by Minnesota Department of Natural Resources. Applicant agrees that plot plan, sketches and specifications submitted herewith and which are approved by the Zoning Official, shall become a part of the permit. **APPLICANT FURTHER AGREES THAT NO PART OF THE SEWAGE SYSTEM SHALL BE COVERED UNTIL IT HAS BEEN INSPECTED AND ACCEPTED.** It shall be the responsibility of the applicant for the permit to notify the Zoning Office (at least 24 hours in advance) that the Septic System is ready for inspection.

X [Signature]
 SIGNATURE APPLICANT/AGENT

DO NOT WRITE BELOW THIS LINE

ZONING DISTRICT & FLOOD PLAIN
 ZONING DISTRICT Shoreland
 LAKE/STREAM/RIVER NAME Mille Lacs
 LAKE/RIVER ID NUMBER 48-0002
 LAKE/RIVER/STREAM CLASSIF. BD
 PARCEL LOCATED IN FLOOD PLAIN? Y ___ N X per 2' contours not @ site
 10/100-YR. FLOOD ELEVATION _____
 LOWEST FLOOR ELEVATION _____
 ELEV. CERTIFICATE REQUIRED Y ___ N ___
 BEFORE CONSTRUCTION Y ___ N ___
 AFTER CONSTRUCTION Y ___ N ___

STRUCTURE SETBACK DISTANCE REQUIREMENTS
 (Measure from eaves or overhang)
 OHW TO LAKE/RIVER/STREAM 75'
 PROPERTY LINE SETBACK (10-ft. / 20-ft.)
 SETBACK TO ROAD R-O-W (30-ft. Twp. / 50-ft. Co., State, Fed.)
 SETBACK TO BLUFF (30-ft.)
SEPTIC SYSTEM SETBACK DISTANCES
 SETBACK TO STRUCTURES (10-ft. Tank / 20-ft. Drainfield)
 OHW TO LAKE/RIVER _____
 PROPERTY LINE SETBACK (10-ft.)
 SETBACK TO ROAD R-O-W (10-ft.)

****ATTACH COPY OF ELEVATION CERTIFICATES****

SOIL BORINGS _____ SEPTIC DESIGN _____ GARBAGE DISP/HOT TUB
 SSF _____ DEPTH TO RESTRICTING LAYER _____ YES ___ NO ___

(circle) SSTS Type Type 1 Type 2 Type 3 Type 4 Type 5

RECOMMENDATIONS: acc bldg 2240 sq ft \$175

EXPIRES IN ONE YEAR • Aitkin County Zoning
 Courthouse - 209 2nd St. NW. Room 100 • Aitkin, Minnesota 56431 \$ 175 KS 3/31/16
 Telephone 218/927-7342 FEE RECEIVED BY DATE

WHITE - COUNTY YELLOW - APPLICANT PINK - TOWNSHIP

FIELD EVALUATION SHEET

NAME Michael Schmid PERMIT # 41825
 PARCEL # 11-1-075300 TWP Hazleton SECTION 6

CHECK THE FOLLOWING PRIOR TO INSPECTION

 _____ NAME OF SITE EVALUATOR
 _____ NAME OF DESIGNER
 _____ NAME OF INSTALLER

 _____ LOT OF RECORD BEFORE 1-21-92 (SL) IR 1-10-95 (NSL), IF NO, ALT. SITE?
 _____ SITE PLAN WITH SETBACK DISTANCES AND DIMENSIONS
 _____ ARE ISTS SITES PROTECTED FROM DAMAGE? IF NOT, WHEN _____
 _____ DESIGN _____ PERC TESTS _____ SOIL BORINGS, 2 PER SITE
 _____ NUMBER OF BEDROOMS (INCLUDE POTENTIAL)
 _____ CROSS SECTION SHEET _____ TRENCH DESIGN SHEET
 _____ MOUND DESIGN SHEET _____ OTHER OR PERFORM.
 _____ PRESSURE DISTRIBUTION SHEET _____ PUMP CALC. TEST
 _____ WATER USE CALCULATIONS _____
 _____ GARBAGE DISPOSAL _____ HOT TUB
 _____ EASEMENTS ON LOT, IS ROAD PUBLIC OR PRIVATE SEE DEED/PLAT
 _____ NATURAL LANDSCAPE PROTECTION PLAN

STAKING: BUILDINGS _____, DRAINFIELD _____, BORINGS _____, WELL _____
 BUILDING SETBACKS: ROAD _____, SIDE _____, REAR _____, BLUFF _____,
 LAKE/RIVER _____

COMPLETE DURING SITE EVALUATION
 _____ BUILDINGS STAKED _____ DRAINFIELD STAKED _____ BORINGS STAKED
 _____ WELL STAKED

SETBACKS (MEASURE DISTANCE)

	<u>DRAINFIELD</u>	<u>HOUSE</u>
FLOOD PLAIN	YES/NO	YES/NO
WETLANDS	YES/NO	YES/NO
LAKE, RIVER, PROTECTED WATERS	_____	2150
ROAD RIGHT OF WAY	_____	79' k
BLUFF	_____	back side of bluff
SIDE LOT LINE	_____	14
REAR LOT LINE	_____	_____
HOUSE OR OTHER STRUCTURE	_____	_____
WELL	_____	_____
EASEMENTS	_____	_____
NEIGHBORING WELL (S) TO ISTS	_____ (1) _____ (2) _____ (3) _____ (4)	_____
DRAINFIELD AREA DISTURBED	_____	_____

pocket yard in front
back side of bluff

CONFORMING SEPTIC SYSTEM: _____ YES _____ NO If no, list reasons below.
 COMMENTS OR PROBLEMS (drainage, swales, wetlands, need gutters, etc.) _____

APPROVED: YES OR NO Yes
 INSPECTORS NAME Burton DATE 4/11/16 # PICTURES _____

SOIL BORING LOGS AND SKETCH PLAN ON REVERSE SIDE

INQPCL-1
Data Set: PRD Production

Parcel Description

3/31/16
08:51:02

Parcel/Ácct : 11-1-075300	10724	Asmt/Tax year: 2015 2016	Type: RE
Pri. owner : 114088		Unit . . . :	Hold tax stmt:
SCHMID, MICHAEL G TRUSTEE		Emergency # :	Lease Type:
Taxpayer . : 114088 FALCO: 1 F.O.		Escrow . . : 183 -	NORTHVIEW BANK
SCHMID, MICHAEL G TRUSTEE		Surveyed . :	Notes :
Ref. parcel : 00-2-110010		Com district: 2	UDI . : 100.00%
Lake #/Name : 48000200 MILLE LACS		MH court nbr:	Billing: P
Physical adr: 21340 PIKE AVE		TIF district:	KD:
	AITKIN MN 56431	User defined:	
Acres . . . : .00		UTA-Twp/City: 11	HAZELTON TWP
Lot/Block . : .		School . . . : 1	AITKIN
Plat/Desc . : 1 MOUNT AND MCQUIL...		AMBU ****	****
Sec/Twp/Rge : 6 44.0 27		00	00 00 00
Description : LOT 12			<--Version: 2

Press Enter to continue or enter new parcel/tax year: 11-1-075300 2016
F1=Help F2=Trans History F3=Exit
F6=Parcel History F7=Name/Addresses F8=Legal F24=More keys

INQPCL-2
Data set: PRD Production

Parcel Description

3/31/16
08:51:06

Parcel/Acct : 11-1-075300 10724 Asmt/Tax year: 2015 2016

Taxpayer: 114088 FALCO: 1 F.O.
SCHMID, MICHAEL G TRUSTEE
9333 MAGGIE LANE
SAVAGE MN 55378

Primary Owner: 114088
SCHMID, MICHAEL G TRUSTEE
9333 MAGGIE LANE
SAVAGE MN 55378

Escrow Agent: 183
NORTHVIEW BANK
ESCROW DEPARTMENT
PO BOX 257
FINLAYSON MN 55735

F1=Help

F3=Exit

F9=Print

More...
F12=Cancel

Supplemental Data for Land Use Permits

A. PRE-EVALUATION INSPECTION REQUEST: Defining and staking the property lines, road right-of-ways, septic sites, and wells are the responsibility of the property owner. In some cases, a registered survey may be required to verify setbacks before granting a permit.

B. Directions to your Property From Aitkin:

From a major intersection: South on 169 to Pike Avenue (1-2 miles before Garrison)

C. PLANNING CHECKLIST (required for all permits):

- | | YES | NO | ??? |
|--|-------------------------------------|-------------------------------------|-------------------------------------|
| 1. Are you aware of setback requirements and will your project meet them? (Note: Setback distances are taken from any projection of the building (i.e. overhangs, eaves, decks, etc.) | <input checked="" type="checkbox"/> | <input type="checkbox"/> | <input type="checkbox"/> |
| 2. Have you taken into consideration locations for future buildings, septic systems, decks, driveways, etc? | <input checked="" type="checkbox"/> | <input type="checkbox"/> | <input type="checkbox"/> |
| 3. Will this structure be used for commercial purposes. | <input type="checkbox"/> | <input checked="" type="checkbox"/> | <input type="checkbox"/> |
| 4. Is your property in a floodplain? (If yes, complete Section D)
<i>If it is, the lowest floor (which includes basement or crawl space, regardless of a dirt floor) must be one foot (1') above the 100-year flood elevation or 3 feet above the highest known water level. A benchmark established by a registered surveyor or licensed engineer may be required before granting a land use permit.</i> | <input type="checkbox"/> | <input checked="" type="checkbox"/> | <input type="checkbox"/> |
| 5. Are there any lowlands or wetlands on or near the site project? | <input type="checkbox"/> | <input type="checkbox"/> | <input checked="" type="checkbox"/> |
| 6. Will your project meet the impervious surface requirements?
<i>Note: In the Shoreland District, structures cannot exceed 15% of lot area and total impervious surfaces cannot exceed 25% of lot area. Lot area must not include wetland or bluff areas or land below the ordinary high water level. Non-shoreland areas have a maximum of 35% total impervious surface.</i> | <input checked="" type="checkbox"/> | <input type="checkbox"/> | <input type="checkbox"/> |

ALL PROPOSED DEVELOPMENT REQUESTS MUST BE CLEARLY STAKED AT ALL FOUR CORNERS. PROPERTY LINES MUST BE FLAGGED NEAR THE PROPOSED CONSTRUCTION. IF STAKES ARE NOT PRESENT OR VISIBLE IT MAY RESULT IN ADDITIONAL FEES AND/OR A DELAY IN THE PERMIT PROCESS. The undersigned hereby makes application for a pre-evaluation permit inspection, agreeing that all setback information and delineation of property lines, well location, road setbacks, and development corners have been properly identified and marked.

Telephone Number between the hours of 8:00 A.M. and 4:00 P.M. 952-484-9594

LANDOWNER SIGNATURE: X 

Shoreland Zoning includes any property within 1,000 feet of a lake, 300 feet of any other river, stream or flowage or the landward extent its floodplain, or within 500 feet of the Mississippi River.

**NON SHORELAND PROPERTIES STOP HERE
SHORELAND PROPERTIES COMPLETE PAGE 2**

SHORELAND PROPERTIES CONTINUED

- | | YES | NO | ??? |
|---|-------------------------------------|-------------------------------------|--------------------------|
| 7. Will your project be less than the maximum structure height allowed in shoreland (35 feet, as measured from the lowest adjoining ground level to the highest point of the roof)? | <input checked="" type="checkbox"/> | <input type="checkbox"/> | <input type="checkbox"/> |
| 8. Is there a steep slope or bluff on or near the site? <i>By Lake</i> | <input checked="" type="checkbox"/> | <input type="checkbox"/> | <input type="checkbox"/> |
| 9. Are you constructing a walkout basement in the shoreland district of a lake, river, or stream (If yes, please provide plan) | <input type="checkbox"/> | <input checked="" type="checkbox"/> | <input type="checkbox"/> |
| 10. Will there be any activity (vegetation removal or earth moving) in the Shore Impact Zone, Bluff Impact Zone or on a steep slope of a lake or river? (If yes, please provide plan) | <input type="checkbox"/> | <input checked="" type="checkbox"/> | <input type="checkbox"/> |
| 11. If you are building an accessory structure, please provide sidewall height and if there will be a loft or second story. (No living quarters, sleeping areas, baths, showers or toilet facilities are allowed in accessory structures.) <i>12' walls, no loft, no second story</i> | | | |

D. NATURAL LANDSCAPE PROTECTION PLAN:

To ensure that earth moving and vegetation removal is within ordinance guidelines, and to ensure activity on your property does not negatively impact the lake or other properties, you may be required to provide additional drawings of your site plan.

12. Setback from the Ordinary High Water Level (OHW) for proposed construction? *? 300+ estimating 130yds*
13. How many cubic yards of fill or excavation will be done on the property? *? will call w/ permit before*
14. How close to the property line will any fill be placed or any excavation be done? *10' permit is approved*
15. If you are constructing a walkout basement, please identify on the drawing where the excavated material will be placed. *N/A*
16. What percent slope of the land currently exists on the construction site? *Flat*
(If the percent slope is greater than 18%, supply copy of Site review from SWCD)
17. How will erosion be controlled during construction? (Attach additional info and drawings as necessary)


18. What will be done after construction to control erosion? *landscaping*

I have read the above and I understand the Natural Landscape Protection Plan as prepared. I hereby agree to implement this plan as part of the Land Use Permit.

<p>X <i>[Signature]</i></p> <p>Landowner Signature</p>	<p>Date</p>	<p><i>[Signature]</i></p> <p>Zoning Official</p>	<p><i>4/13/16</i></p> <p>Date</p>
--	-------------	--	-----------------------------------

AITKIN COUNTY BUILDING PERMIT SITE PLAN


Please indicate the location of: Wells, well setback to system components, buildings, septic system components, reserved septic system area, property lines, waterways, and buried lines. Include size, length, and appropriate distances from fixed reference points. Provide a North directional arrow!

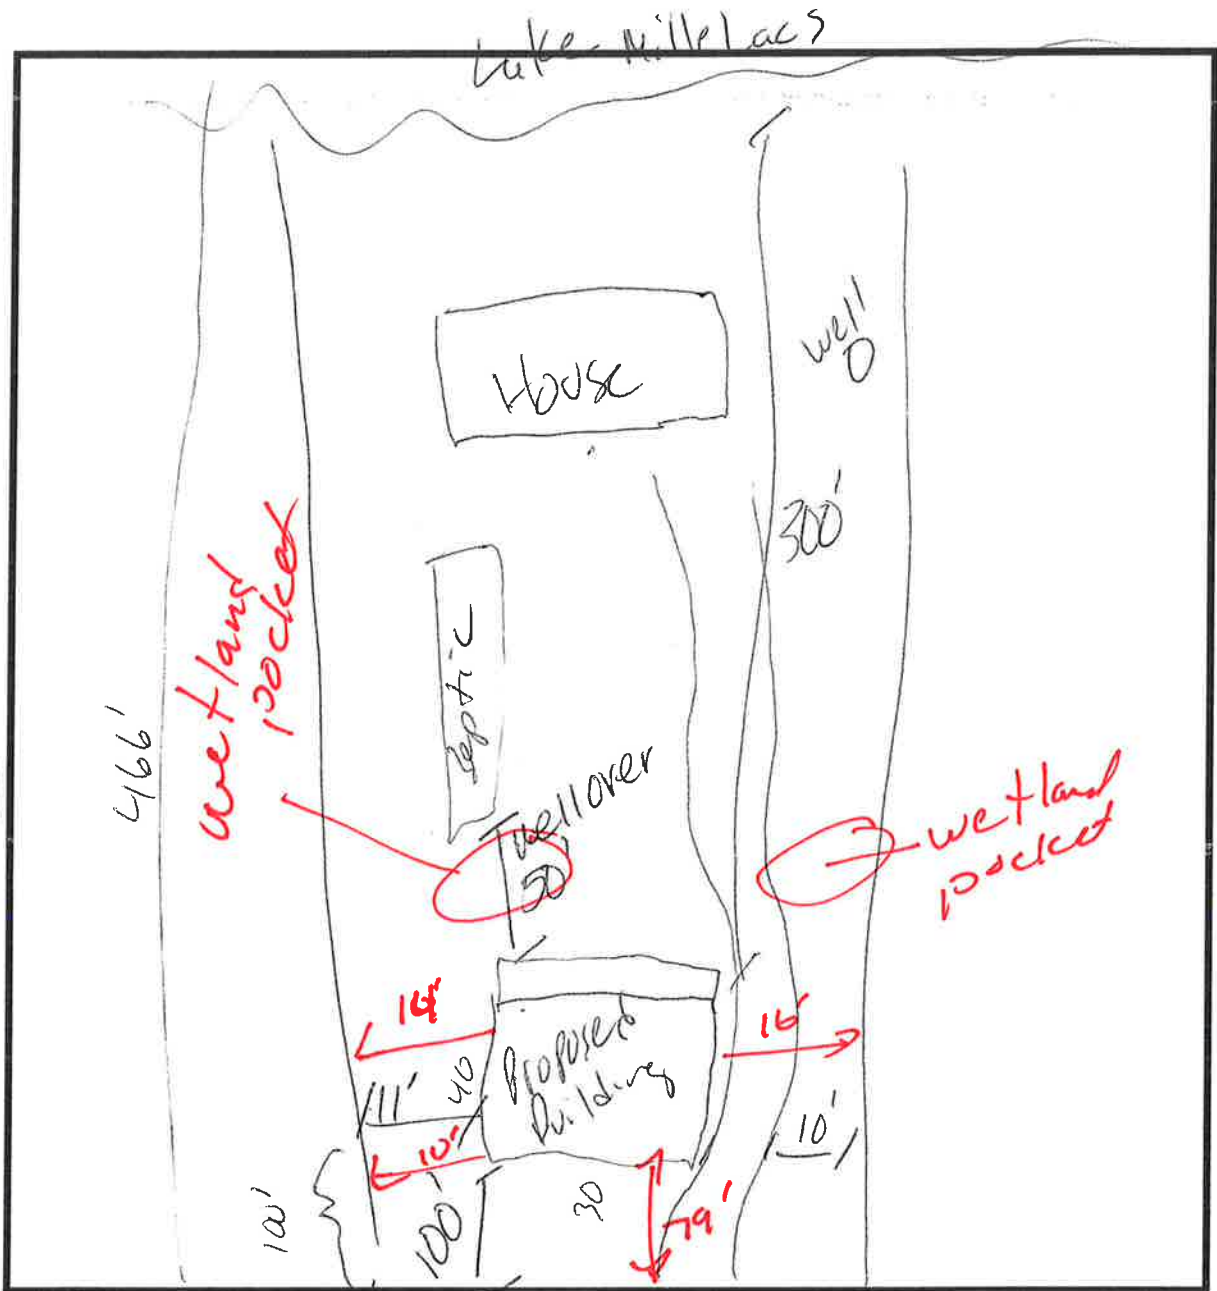

measurements per
phone conversation

AITKIN COUNTY BUILDING PERMIT SITE PLAN

Please indicate the location of: Wells, well setback to system components, buildings, septic system components, reserved septic system area, property lines, waterways, and buried lines. Include size, length, and appropriate distances from fixed reference points. Provide a North directional arrow!

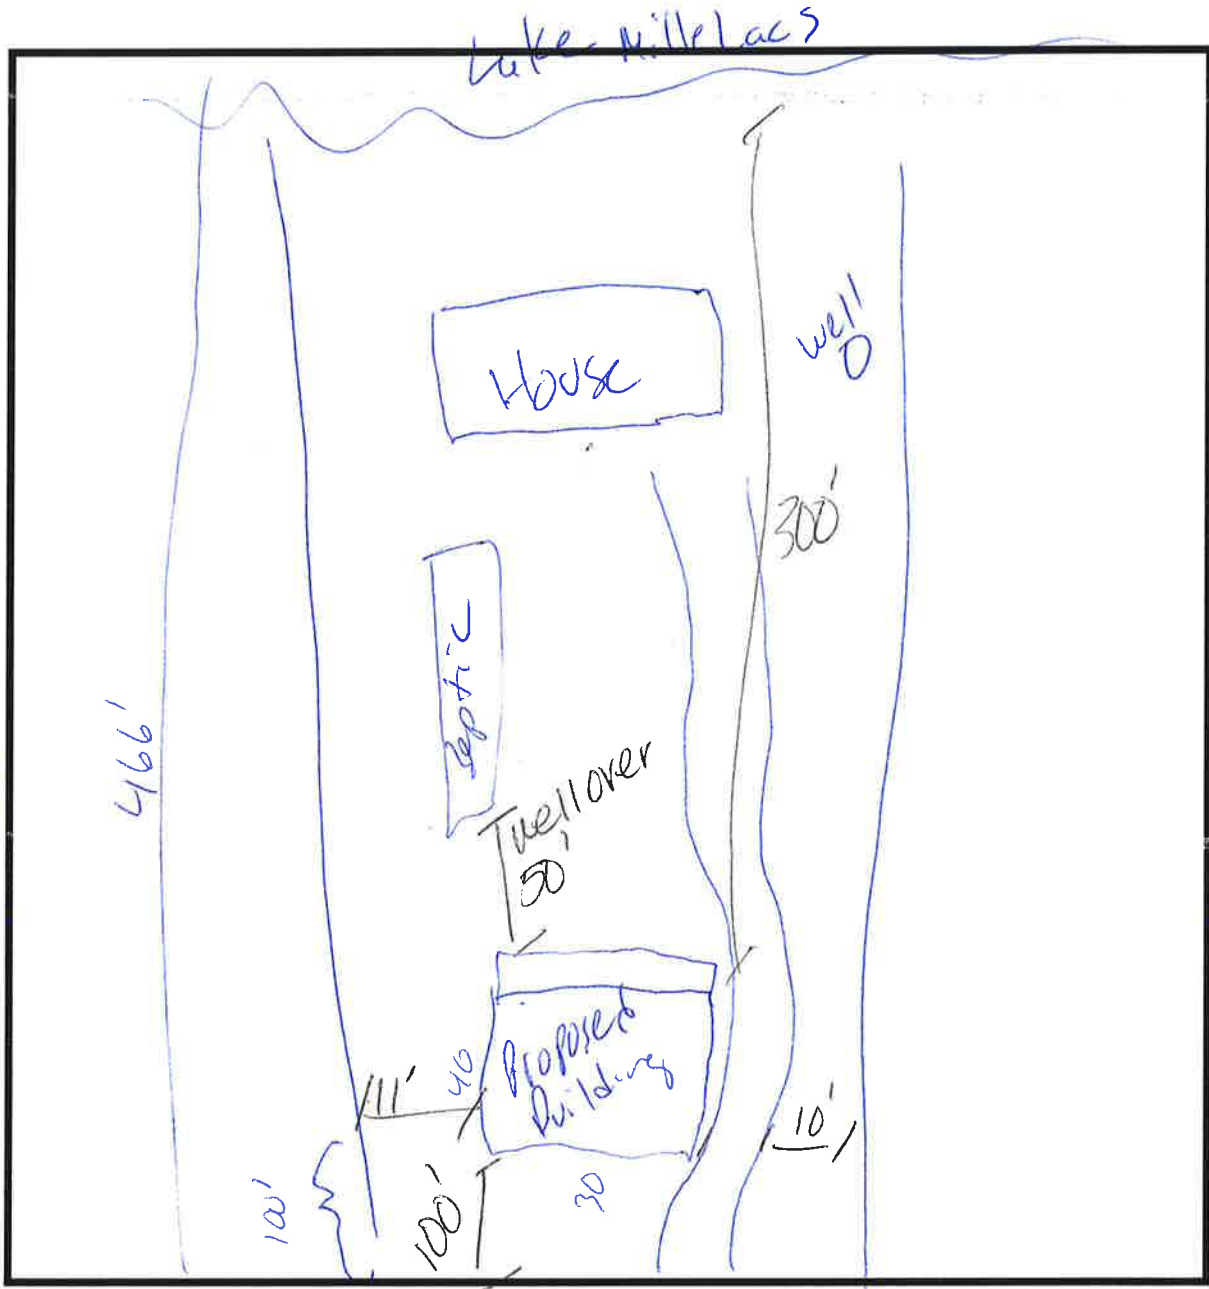

Measurements per
phone conversation
3/31/16

SURVEY FOR: Crown Bank

SURVEYED: 3/27/2012 DRAFTED: 3/28/2012

LEGAL DESCRIPTION AS PROVIDED:

Parcel "A":
Lot 12 of MOUNT & MCQUILLIN'S MILLE LACS LAKE ACRES, as of public record, Aitkin County, Minnesota.

Subject to easements of record.
Subject to the rights of the public in Pike Avenue (County Road NO.85).


Parcel "B":
Lot 13 and the NE 1/4 of Lot 14 of MOUNT & MCQUILLIN'S MILLE LACS LAKE ACRES, as of public record, Aitkin County, Minnesota.

Subject to easements of record.
Subject to the rights of the public in Pike Avenue (County Road NO.85).

STANDARD SYMBOLS & CONVENTIONS:

CERTIFICATION: I hereby certify that this survey was prepared by me or under my direct supervision and that I am a Professional Licensed Surveyor under the Laws of the State of Minnesota.

Larry High PL S 24332
Doug Plahn PL S 49495

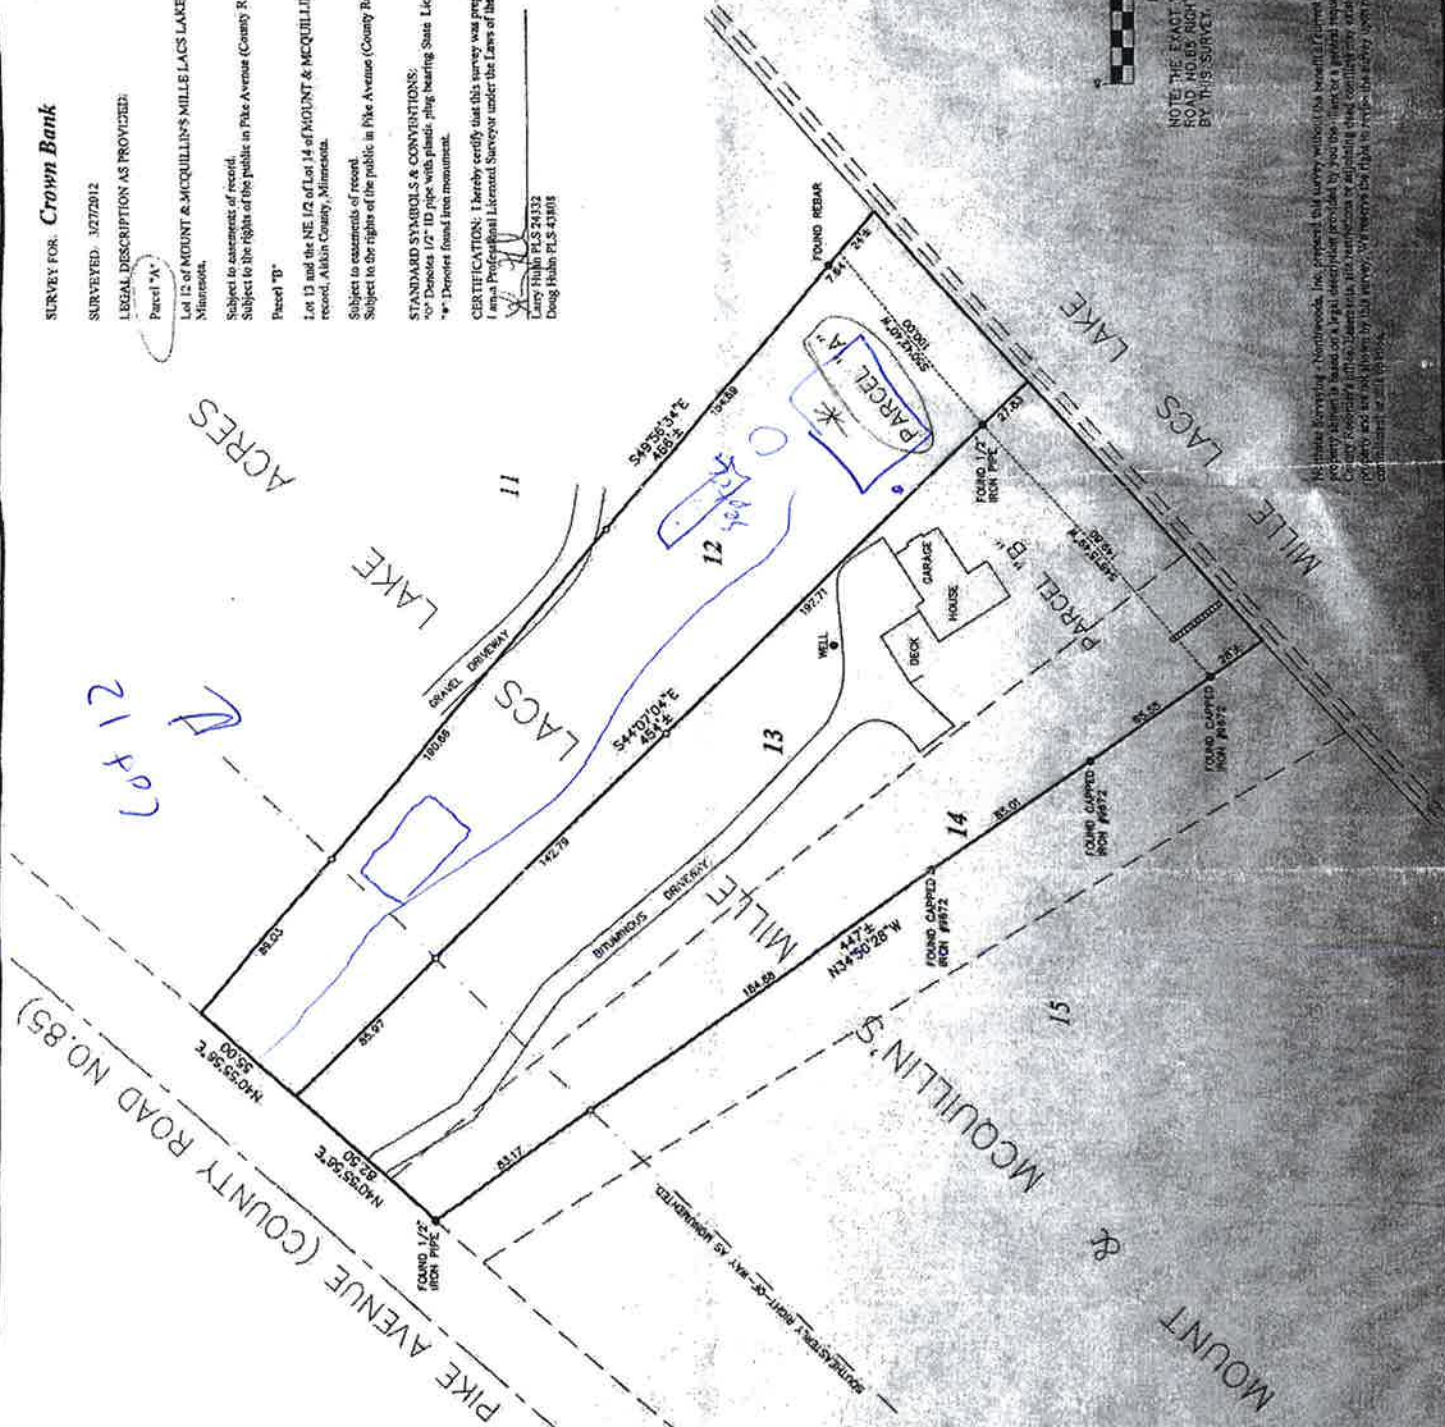



AITKIN COUNTY ZONING

PERMIT NUMBER **41825**

PARCEL NUMBER **11-6-075300**

Location **12** **6** **44** **27**
Lot Block Gov't Lot Section Twp. Rge.

Mount + McQuillans

Issued **4/13/10** To **Michael Schmid**

Nature of Authorization **30 x 40 storage / accessory structure**

New Construction Alteration

Sewer Installation

Flood Plain and Lowest Floor Elev. _____

This permit expires one year from date of issuance
NOT TRANSFERABLE

NOTE:

This permit must be posted in a conspicuous place on premises on which work is to be done and remain until work has been completed and inspected.

Baby Sauske
ZONING ADMINISTRATOR

No Portion of any Sewage Disposal System shall be Covered Prior to Inspection.