


SECTION 6

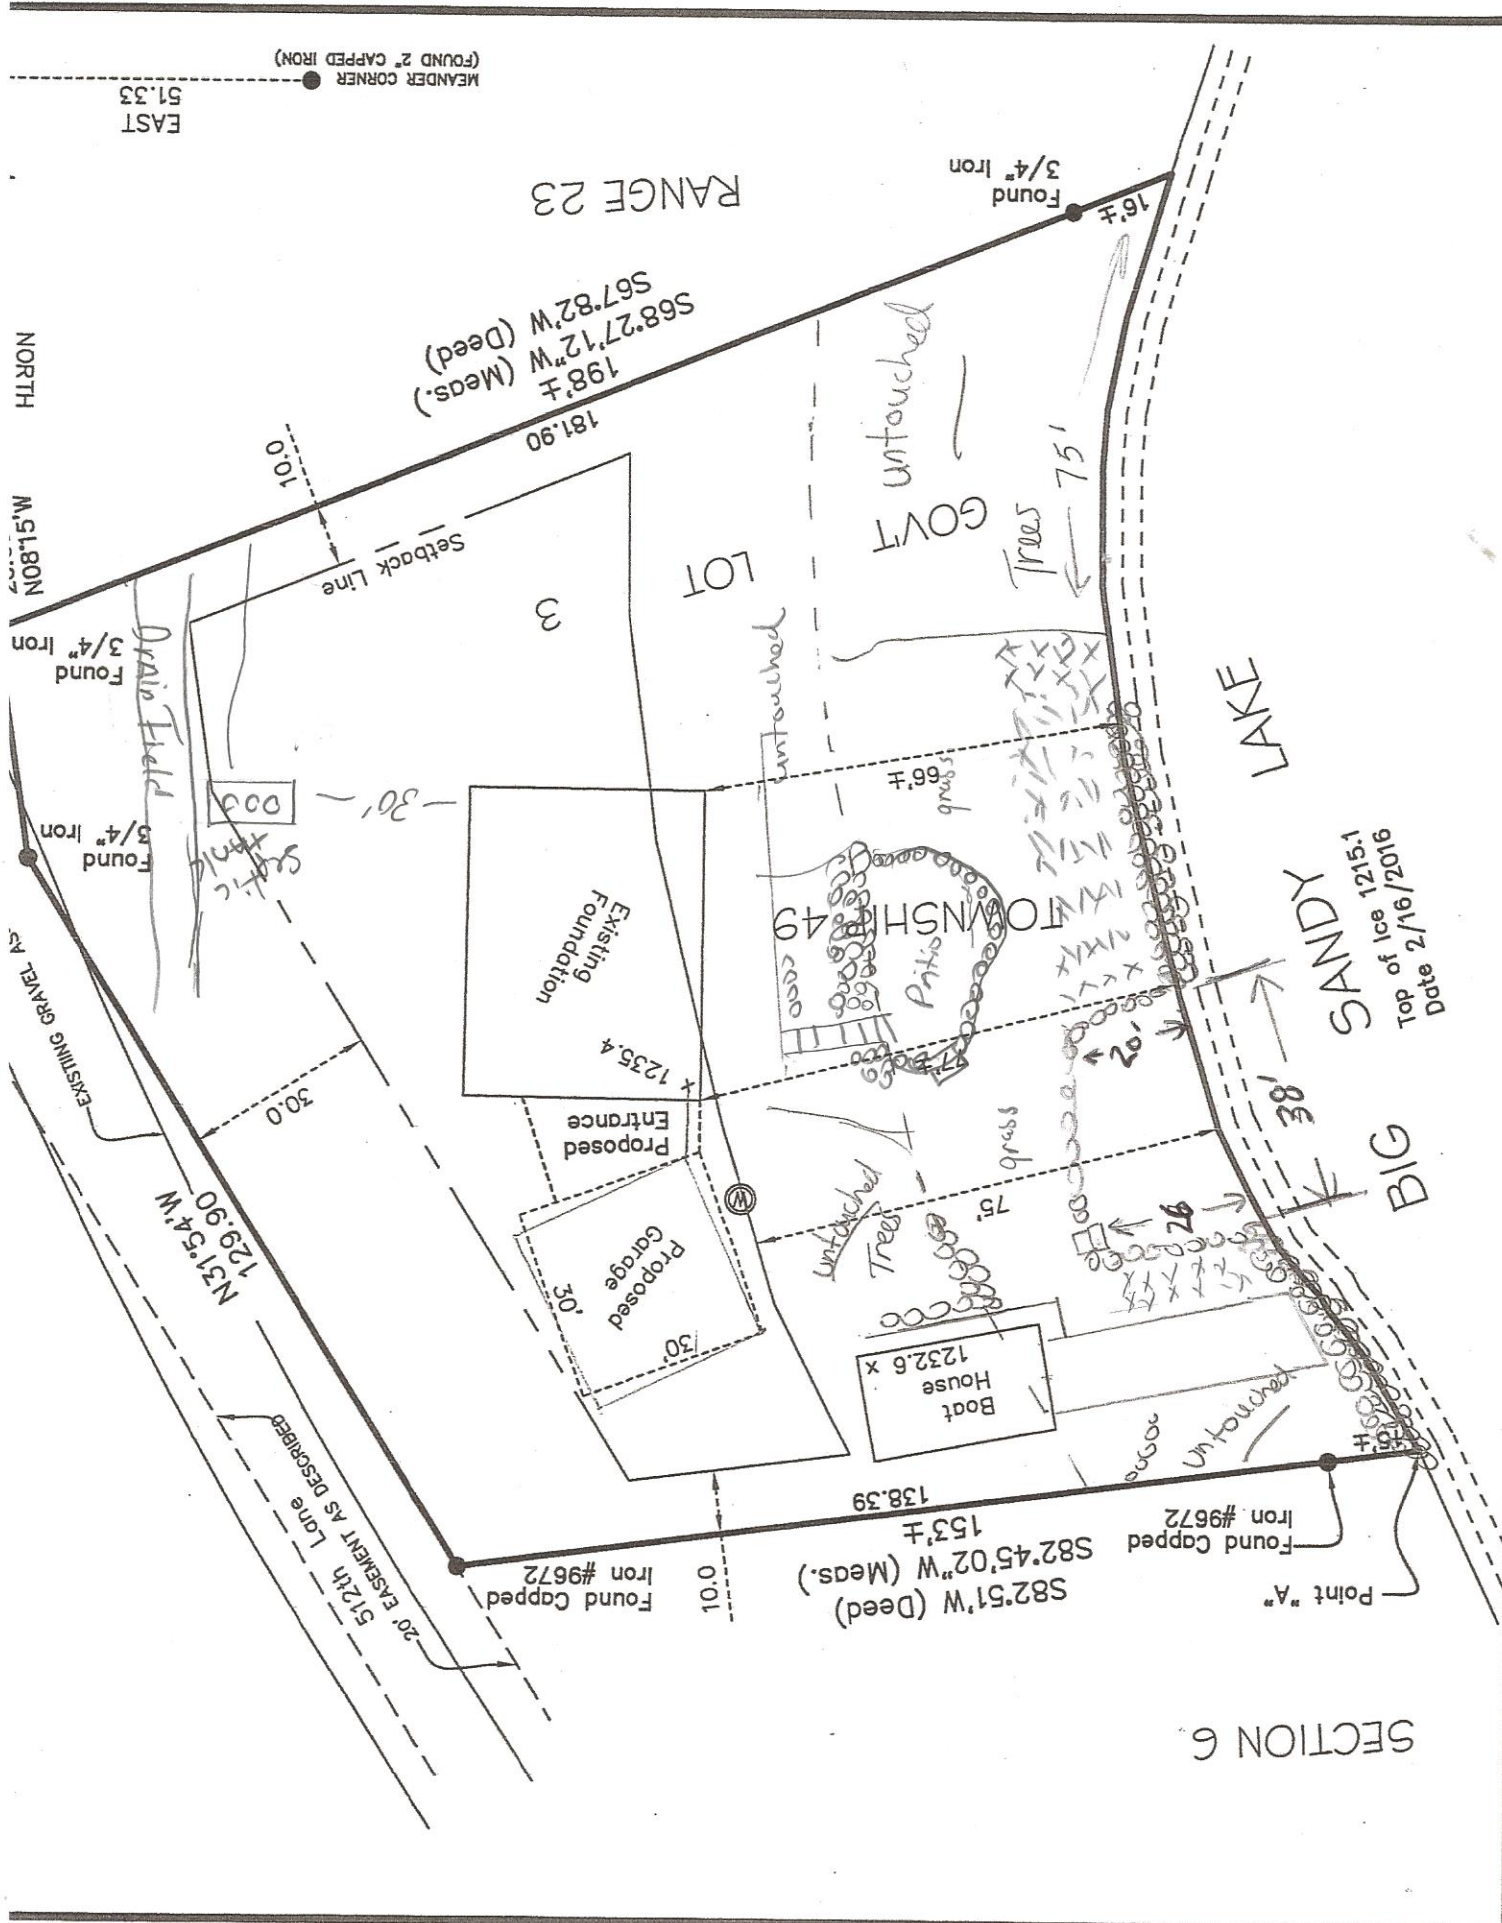

Date 2/16/2016
Top of Ice 1215.1'

LAKE

SANDY

BIG

RANGE 23


LOT

untouched
GOVT
Trees 75'

untouched

case

untouched
Trees

Boat House
1232.6 x

Existing Foundation

Proposed Garage

Proposed Entrance

N31°54'W
129.90'

N08°15'W

NORTH

EXISTING GRAVEL AS

Found 3/4" Iron

Found 3/4" Iron

