


Diagram as of -
5-10-2016

MAP "A"

AITKIN COUNTY BUILDING PERMIT SITE PLAN

Please indicate the location of: Wells, well setback to system components, buildings, septic system components, reserved septic system area, property lines, waterways, and buried lines. Include size, length, and appropriate distances from fixed reference points. Provide a North directional arrow!

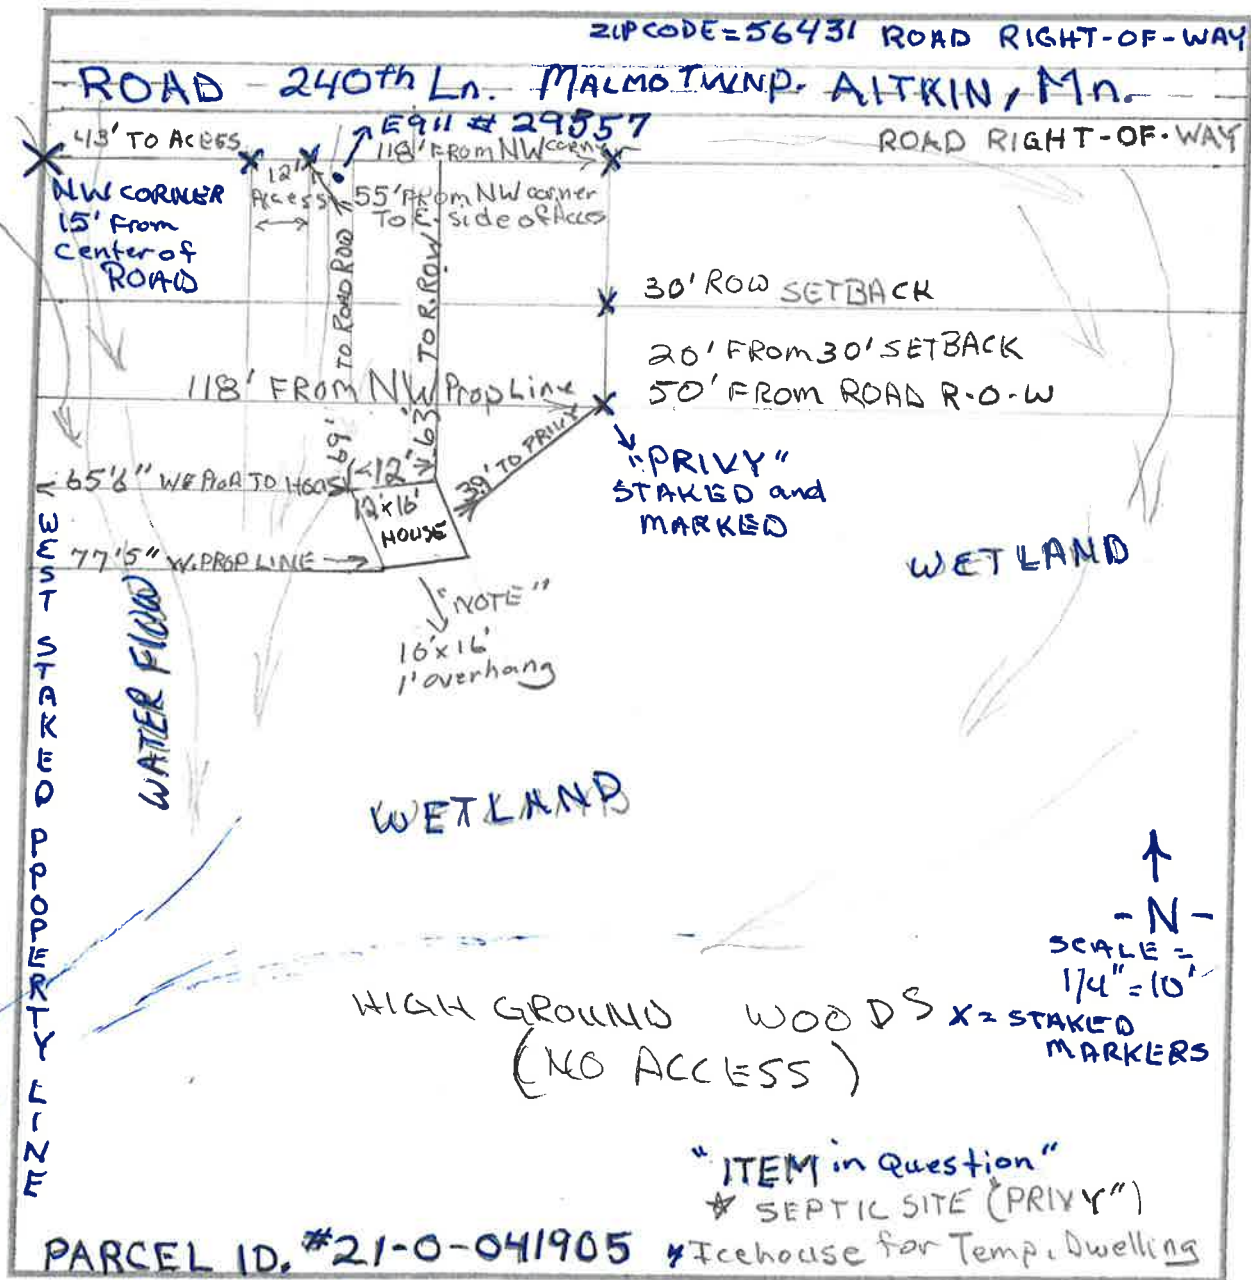

Parcel # 21-0-041905^{100'}

STATE PROP. 200'

300'

330'

MAP "B"

ROAD R.O.W

ZIP CODE


5-10-2016

ROAD - 240th Ln. MALMO Twp. + AITKIN, Mn. 56431

-ROAD RIGHT-OF-WAY-

WEST STAKED PROPERTY LINE

EAST STAKED PROPERTY LINE

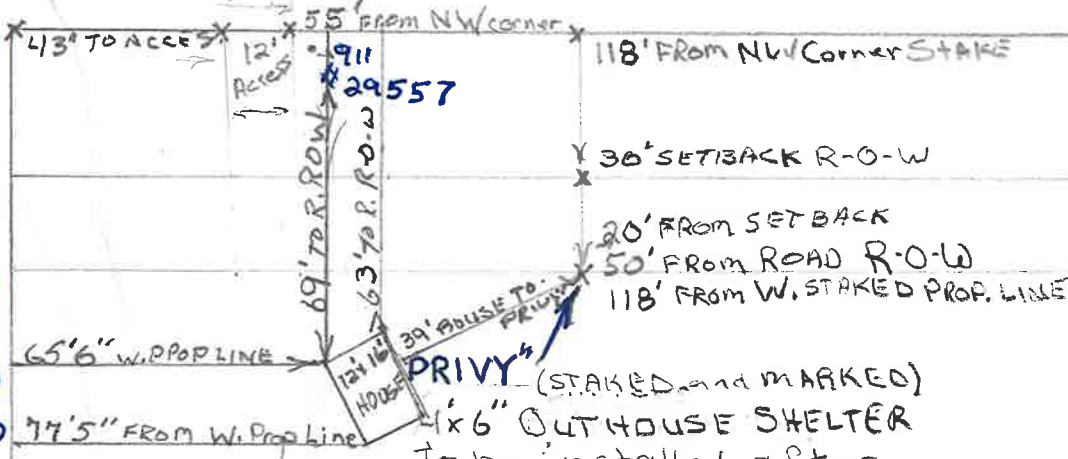

PRIVY (STAKED and MARKED)

4x6 OUTHOUSE SHELTER
to be installed after
completion of septic work.

12' ICEHOUSE (Temp Dwelling)
12' x 16' (10' x 16' with
1' overhang.)

WATER FLOW

WATER FLOW

WETLANDS

WETLANDS

WOODS
(DRY LAND
NO ACCESS)



330'
FROM
WEST PROP. LINE

SCALE:
1/4" inch = 10' FEET
X = STAKED MARKER