


CLIENT: Wright

DATE: 10-30-12

MAP DRAWN TO SCALE WITH A NORTH ARROW

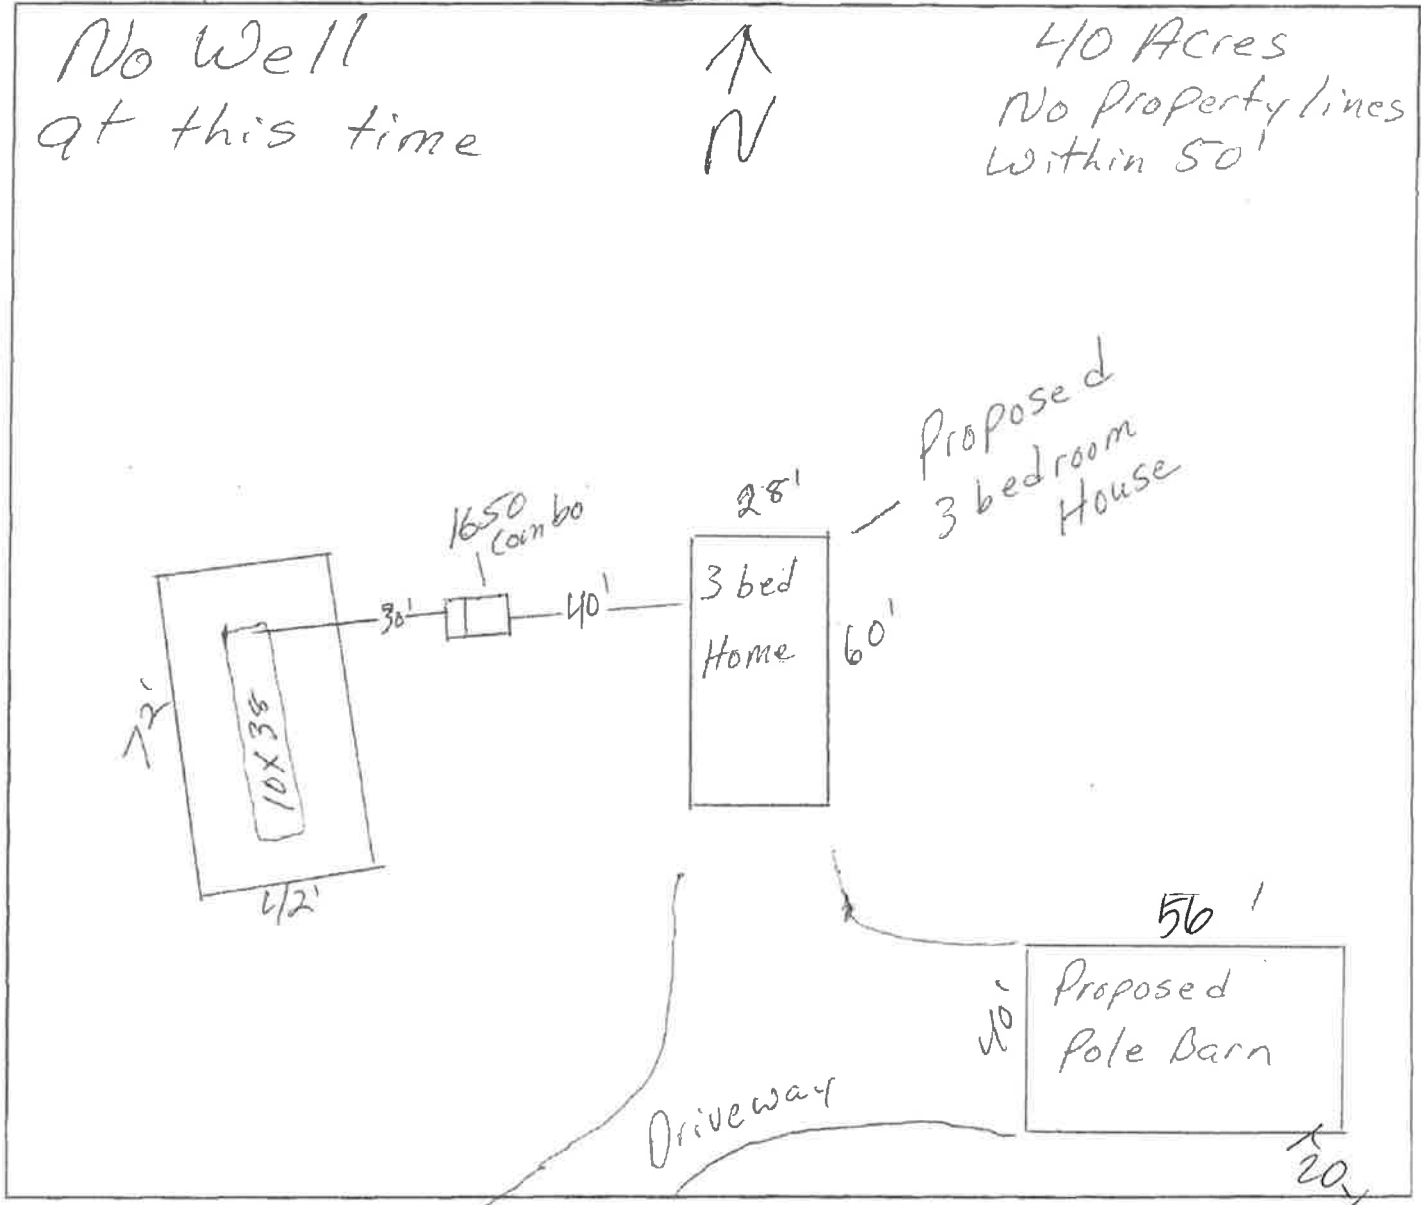

CHECK OFF LIST-HAVE ALL OF THE FOLLOWING BEEN DRAWN ON THE MAP??

SHOW EXISTING OR PROPOSED

- WATER WELLS WITHIN 100 FT OF TREATMENT AREAS
- PRESSURE WATER LINES WITHIN 10 FT OF TREATMENT AREAS
- STRUCTURES
- ALL SOIL TREATMENT AREAS
- HORIZONTAL AND VERTICAL REFERENCE
- POINT OF SOIL BORINGS
- LOT EASEMENTS
- DISTURBED/ COMPACTED AREAS
- SITE PROTECTION-LATHE AND RIBBON EVERY 15 FT
- ACCESS ROUTE FOR TANK MAINTENANCE
- LOT IMPROVEMENTS
- ALL ISTS COMPONENTS
- DIRECTION OF SLOPE
- ALL LOT DIMENSIONS

REQUIRED SETBACKS

- STRUCTURES
- OHWL
- PROPERTY LINES

COMMENTS:

DESIGNER SIGNATURE Redk
LICENSE# 211

KT 10-31-12

INDICATE ELEVATIONS

BENCHMARK

- ELEVATION OF SEWER LINE @ HOUSE 100
- ELEVATION @ TANK INLET 102
- ELEVATION @ BOTTOM OF ROCK LAYER 78
- ELEVATION @ BOTTOM OF BORING OR RESTRICTIVE LAYER 101
- ELEVATION OF PUMP 106
- ELEVATION OF DISTRIBUTION DEVICE 97.25

DATE 10-30-12