


CLIENT: Wright

DATE: 10-30-12

MAP DRAWN TO SCALE WITH A NORTH ARROW

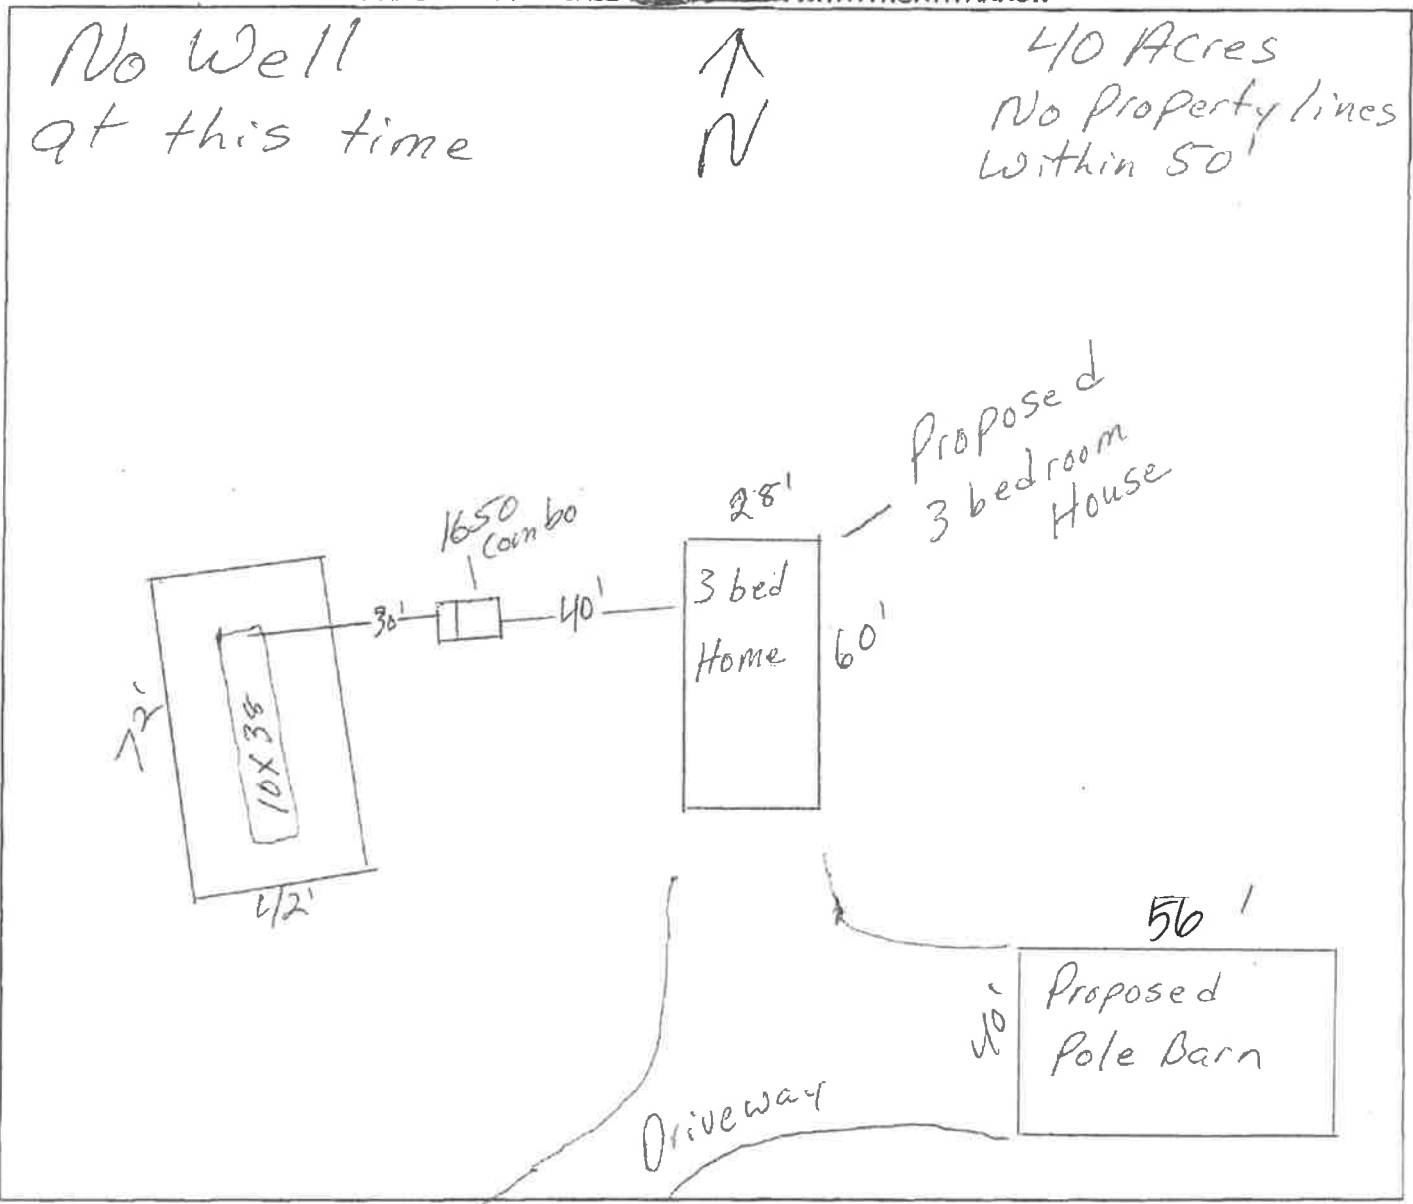

No Well
at this time



40 Acres
No Property lines
Within 50'

CHECK OFF LIST-HAVE ALL OF THE FOLLOWING BEEN DRAWN ON THE MAP??

SHOW EXISTING OR PROPOSED

- WATER WELLS WITHIN 100 FT OF TREATMENT AREAS
- PRESSURE WATER LINES WITHIN 10 FT OF TREATMENT AREAS
- STRUCTURES
- ALL SOIL TREATMENT AREAS
- HORIZONTAL AND VERTICAL REFERENCE
- POINT OF SOIL BORINGS
- LOT EASEMENTS
- DISTURBED/ COMPACTED AREAS
- SITE PROTECTION-LATHE AND RIBBON EVERY 15 FT
- ACCESS ROUTE FOR TANK MAINTENANCE
- LOT IMPROVEMENTS
- ALL ISTS COMPONENTS
- DIRECTION OF SLOPE
- ALL LOT DIMENSIONS

REQUIRED SETBACKS

- STRUCTURES
- OHWL
- PROPERTY LINES

COMMENTS:

INDICATE ELEVATIONS

- BENCHMARK**
- ELEVATION OF SEWER LINE @ HOUSE 100
 - ELEVATION @ TANK INLET 102
 - ELEVATION @ BOTTOM OF ROCK LAYER 98
 - ELEVATION @ BOTTOM OF BORING OR RESTRICTIVE LAYER 101
 - ELEVATION OF PUMP 106
 - ELEVATION OF DISTRIBUTION DEVICE 97.25

DESIGNER SIGNATURE Redk
LICENSE# 211

DATE 10-30-12

(KI) 10-31-12